

**CITY OF SACRAMENTO**

**Permit No: 9807215**

**1231 I Street, Sacramento, CA 95814**

**Insp Area: 4**

**Site Address: 901 EL CAMINO AV SAC**

**Sub-Type: ACOM**

**Parcel No: 2650321016**

**Housing (Y/N): N**

**CONTRACTOR**

SENTINEL FIRE EQUIP  
5702 BROADWAY  
SACRAMENTO CA

95820

**OWNER**

TAYLOR ROBERT P & JANICE M  
901 EL CAMINO AV  
SACRAMENTO CA

95815

**ARCHITECT**

**Nature of Work: ANSUL HOOD SYSTEM**

**CONSTRUCTION LENDING AGENCY :** I hereby affirm under penalty of perjury that there is a construction lending agency for the performance of the work for which this permit is issued (Sec. 3097, Civ. C).

Lender's Name \_\_\_\_\_ Lender's Address \_\_\_\_\_

**LICENSED CONTRACTORS DECLARATION:** I hereby affirm under penalty of perjury that I am licensed under provisions of Chapter 9 (commencing with section 7000) of Division 3 of the Business and Professions Code and my license is in full force and effect.

License Class C16 License Number 369137 Date 7-29-98 Contractor Signature SENTINEL FIRE EQUIP

**OWNER-BUILDER DECLARATION:** I hereby affirm under penalty of perjury that I am exempt from the contractors License Law for the following reason (Sec. 7031.5, Business and Professions Code; any city or county which requires a permit to construct, alter, improve, demolish, or repair any structure, prior to its issuance, also requires the applicant for such permit to file a signed statement that he or she is licensed pursuant to the provisions of the Contractors License Law (Chapter 9 (commencing with Section 7000) of Division 8 of the Business and Professions Code) or that he or she is exempt therefrom and the basis for the alleged exemption. Any violation of Section 7031.5 by any applicant for a permit subjects the applicant to a civil penalty of not more than five hundred dollars (\$500.00);

\_\_\_\_ I, as a owner of the property, or my employees with wages as their sole compensation, will do the work, and the structure is not intended or offered for sale (Sec. 7044, Business and Professional Code: The Contractors License Law does not apply to an owner of property who builds or improves thereon, and who does such work himself or herself or through his/her own employees, provided that such improvements are not intended or offered for sale. If, however, the building or improvement is sold within one year of completion, the owner-builder will have the burden of proving that he/she did not build or improve for the purpose of sale.)

\_\_\_\_ I, as owner of the property, am exclusively contracting with licensed contractors to construct the project (Sec. 7044, Business and Professions Code: The Contractors License Law does not apply to an owner of property who builds or improves thereon, and who contracts for such projects with a contractor(s) licensed pursuant to the Contractors License Law).

\_\_\_\_ I am exempt under Sec. \_\_\_\_\_ B & PC for this reason: \_\_\_\_\_

Date \_\_\_\_\_ Owner Signature \_\_\_\_\_

**IN ISSUING THIS BUILDING PERMIT,** the applicant represents, and the city relies on the representation of the applicant, that the applicant verified all measurements and locations shown on the application or accompanying drawings and that the improvement to be constructed does not violate any law or private agreement relating to permissible or prohibited locations for such improvements. This building permit does not authorize any illegal location of any improvement or the violation of any private agreement relating to location of improvements.

I certify that I have read this application and state that all information is correct. I agree to comply with all city and county ordinances and state laws relating to building construction and herby authorize representative(s) of this city to enter upon the abovementioned property for inspection purposes.

Date 7-29-98 Applicant/Agent Signature Wayne Garrison

**WORKER'S COMPENSATION DECLARATION:** I hereby affirm under penalty of perjury one of the following declarations:

\_\_\_\_ I have and will maintain a certificate of consent to self-insure for workers' compensation as provided for by Section 3700 of the Labor Code, for the performance of work for which the permit is issued.

\_\_\_\_ I have and will maintain workers' compensation insurance, as required by Section 3700 of the Labor Code, for the performance of the work for which this permit is issued. My workers' compensation insurance carrier and policy number are:

Carrier GOLDEN EAGLE Policy Number 11-98 NWC41938800

\_\_\_\_ (This section need not be completed if the permit is for \$100 or less) I certify that in the performance of the work for which this permit is issued, I shall not employ any person in any manner so as to become subject to the workers' compensation laws of California and agree that if I should become subject to the workers' compensation provisions of Section 3700 of the Labor Code, I shall forthwith comply with those provisions.

Date 7-29-98 Applicant Signature Wayne Garrison

**WARNING: FAILURE TO SECURE WORKER'S COMPENSATION COVERAGE IS UNLAWFUL AND SHALL SUBJECT AN EMPLOYER TO CRIMINAL PENALTIES AND CIVIL FINES UP TO ONE HUNDRED THOUSAND DOLLARS (\$100,000) IN ADDITION TO THE COST OF COMPENSATION, DAMAGES AS PROVIDED FOR IN SECTION 3706 OF THE LABOR CODE, INTEREST AND ATTORNEY'S FEE.**

**THIS PERMIT SHALL EXPIRE BY LIMITATION IF WORK IS NOT COMMENCED WITHIN 180 DAYS.**

# MEMORANDUM

*Sacramento Fire Department*

To: BUILDING DEPARTMENT

Date: 8-11-98

From: Gordon Duncan,  
Fire Marshal

Subject: **FIRE SYSTEM INSPECTION**

A final inspection of the newly installed fire system at:

901 EL CAMINO AVE

has been conducted by Inspector R. Robles

on 8-11-98.

98-07215-C


Permit Number

\_\_\_\_\_  
Square Footage



KIT Hood

Type Inspection

The system is acceptable by this department.

  
\_\_\_\_\_  
By: Ross L. Woodman,  
Fire Prevention Officer II

98-153  
F. D. Reference Number

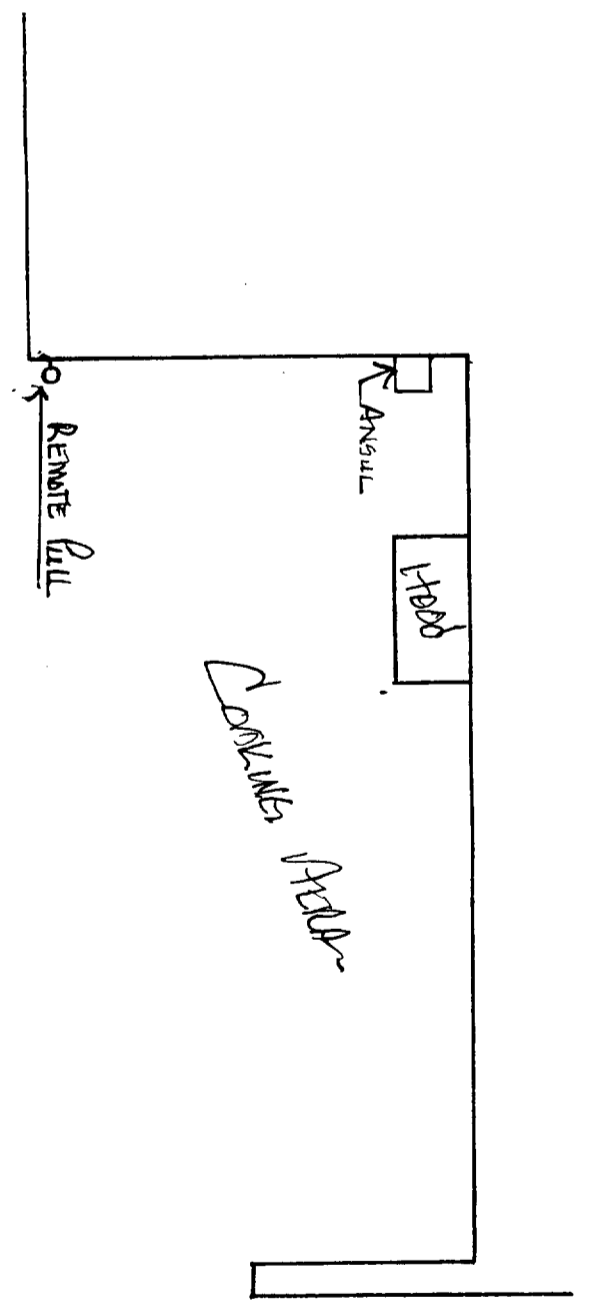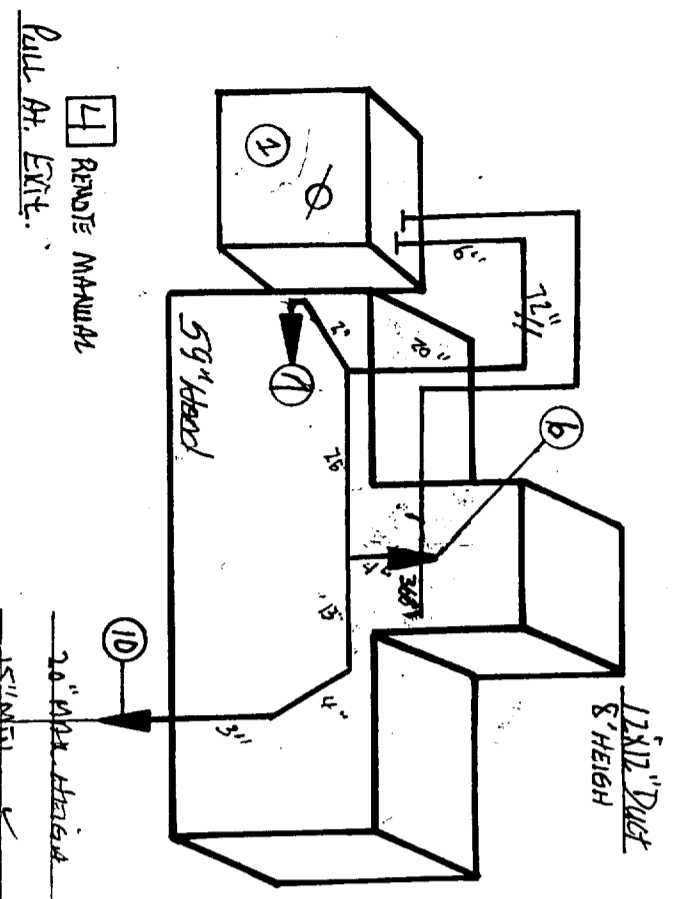

9807215

**APPROVED**  
 E.H. [Signature]  
 SACRAMENTO  
 FIRE DEPARTMENT  
 7-29-98

\*ALL PIPING IS 3/8" BLK.-SCHD. 40  
 \*AS BUILT PIPING DIMENSIONS TO BE FURNISHED AT FINAL TEST  
 \*TO BE INSTALLED AS-PER ANSUL MANUAL, NFPA 17A, AND LOCAL FIRE AUTH.  
 \*MAX. FLOW POINTS IS (11), BEING USED IS (5) FLOW POINTS  
 SINGLE Filter Bank

Established 1929 <b>SENTINEL FIRE</b> EQUIPMENT COMPANY C-16 LICENSE NO. 369137 5702 EROADWAY, SACRAMENTO, CA 95820 (916) 455-5630		SALES AND SERVICE ANSUL AUTHORIZED DISTRIBUTOR RESTAURANT HOOD SYSTEMS VEHICLE FIRE PROTECTION			
BRAND <b>ANSUL</b> MODEL <b>R102 711300</b> 360L DATE <b>7-28-98</b>		JOB NAME <b>POPEYE'S</b> ADDRESS <b>901 EL DOMINO AVE</b> CITY <b>SACRAMENTO CA.</b>			
DRAWN BY: <b>[Signature]</b> SCALE: <b>1/4" = 1'-0"</b>					
NO.	DESCRIPTION	PART NO	NO.	DESCRIPTION	PART NO
1	ANSUL (R102) SYSTEM	79290	6	DUCT NOZZLE	2W 419337
2	OTHER		7	PLENUM NOZZLE-8'	1W 419335
3	GAS VALVE 3/4" MECA	55598	8	PLENUM NOZZLE-4'	13
4	REMOTE PULL BOX	4835	9	FRYER NOZZLE	14
5	DETECTOR BRACKET 360	56837	10	RANGE/ NOZZLE	260 15