

**CITY OF SACRAMENTO**

**1231 I Street, Sacramento, CA 95814**

**Permit No: 9902218**

**Insp Area: 1**

**Site Address: 7901 COLLEGE TOWN DR SAC**

**Parcel No: 079-0010-024**

**Sub-Type: AOTHR**

**Housing (Y/N): N**

**CONTRACTOR**  
ENVIRONMENTAL RESOLUTIONS INC

**OWNER**

**ARCHITECT**  
EXXON CORPORATION

74 DIGITAL DR STE#6  
NOVATO CA

94949

800 BELL ST  
HOUSTON TX

77002

**Nature of Work: U.G PIPING FOR SOILS REMEDIATION EQUIP.FROM MONITORING  
WELLS TO VAULT BOX.**

**CONSTRUCTION LENDING AGENCY :** I hereby affirm under penalty of perjury that there is a construction lending agency for the performance of the work for which this permit is issued (Sec. 3097, Civ. C).

Lender's Name \_\_\_\_\_ Lender's Address \_\_\_\_\_

**LICENSED CONTRACTORS DECLARATION:** I hereby affirm under penalty of perjury that I am licensed under provisions of Chapter 9 (commencing with section 7000) of Division 3 of the Business and Professions Code and my license is in full force and effect.

License Class AHA2C10 License Number 611383 Date 3/10/99 Contractor Signature Chris Pige

**OWNER-BUILDER DECLARATION:** I hereby affirm under penalty of perjury that I am exempt from the contractors License Law for the following reason (Sec. 7031.5, Business and Professions Code; any city or county which requires a permit to construct, alter, improve, demolish, or repair any structure, prior to its issuance, also requires the applicant for such permit to file a signed statement that he or she is licensed pursuant to the provisions of the Contractors License Law (Chapter 9 (commencing with Section 7000) of Division 8 of the Business and Professions Code) or that he or she is exempt therefrom and the basis for the alleged exemption. Any violation of Section 7031.5 by any applicant for a permit subjects the applicant to a civil penalty of not more than five hundred dollars (\$500.00);

\_\_\_\_\_, I, as a owner of the property, or my employees with wages as their sole compensation, will do the work, and the structure is not intended or offered for sale (Sec. 7044, Business and Professional Code: The Contractors License Law does not apply to an owner of property who builds or improves thereon, and who does such work himself or herself or through his/her own employees, provided that such improvements are not intended or offered for sale. If, however, the building or improvement is sold within one year of completion, the owner-builder will have the burden of proving that he/she did not build or improve for the purpose of sale.)

\_\_\_\_\_, I, as owner of the property, am exclusively contracting with licensed contractors to construct the project (Sec. 7044, Business and Professions Code: The Contractors License Law does not apply to an owner of property who builds or improves thereon, and who contracts for such projects with a contractor(s) licensed pursuant to the Contractors License Law).

\_\_\_\_\_ I am exempt under Sec. \_\_\_\_\_ B & PC for this reason: \_\_\_\_\_

Date \_\_\_\_\_ Owner Signature \_\_\_\_\_

**IN ISSUING THIS BUILDING PERMIT,** the applicant represents, and the city relies on the representation of the applicant, that the applicant verified all measurements and locations shown on the application or accompanying drawings and that the improvement to be constructed does not violate any law or private agreement relating to permissible or prohibited locations for such improvements. This building permit does not authorize any illegal location of any improvement or the violation of any private agreement relating to location of improvements.

I certify that I have read this application and state that all information is correct. I agree to comply with all city and county ordinances and state laws relating to building construction and hereby authorize representative(s) of this city to enter upon the above mentioned property for inspection purposes.

Date 3/10/99 Applicant/Agent Signature Chris Pige

**WORKER'S COMPENSATION DECLARATION:** I hereby affirm under penalty of perjury one of the following declarations:

\_\_\_\_\_ I have and will maintain a certificate of consent to self-insure for workers' compensation as provided for by Section 3700 of the Labor Code, for the performance of work for which the permit is issued.

\_\_\_\_\_ I have and will maintain workers' compensation insurance, as required by Section 3700 of the Labor Code, for the performance of the work for which this permit is issued. My workers' compensation insurance carrier and policy number are:

Carrier State Fund Policy Number 1200363-98 Exp Date 7/1/98

\_\_\_\_\_ (This section need not be completed if the permit is for \$100 or less) I certify that in the performance of the work for which this permit is issued, I shall not employ any person in any manner so as to become subject to the workers' compensation laws of California and agree that if I should become subject to the workers' compensation provisions of Section 3700 of the Labor Code, I shall forthwith comply with those provisions.

Date 3/10/99 Applicant Signature Chris Pige

**WARNING:** FAILURE TO SECURE WORKER'S COMPENSATION COVERAGE IS UNLAWFUL AND SHALL SUBJECT AN EMPLOYER TO CRIMINAL PENALTIES AND CIVIL FINES UP TO ONE HUNDRED THOUSAND DOLLARS (\$100,000) IN ADDITION TO THE COST OF COMPENSATION, DAMAGES AS PROVIDED FOR IN SECTION 3706 OF THE LABOR CODE, INTEREST AND ATTORNEY'S FEE.

**THIS PERMIT SHALL EXPIRE BY LIMITATION IF WORK IS NOT COMMENCED WITHIN 180 DAYS.**

PERMIT NO.

97022780

CITY OF SACRAMENTO  
FORM 37 (RXXM) 2008  
BUILDING INSPECTIONS DIVISION

AREA NO.

2

WHEN CORRECTIONS HAVE BEEN MADE CALL **264-5191** FOR REINSPECTION OF WORK

JOB LOCATION

101 College Ln  
UCJG

INSPECTION REQUESTED

THE UNDERSIGNED BUILDING PLUMBING MECHANICAL ELECTRICAL  
INSPECTOR THIS DAY INSPECTED THIS STRUCTURE FOR THE REQUESTED INSPECTION AND FOUND THE  
FOLLOWING VIOLATIONS OF CITY AND/OR STATE LAWS GOVERNING SAME

min 24" depth to rough  
concrete in Terrace Area

NOTARY PUBLIC

*[Signature]*

DATE

3/15/98

BUILDING INSPECTIONS 264-5191

INSPECTOR'S SIGNATURE

APPLICATION FOR [REDACTED] BUILDING PERMIT

44 02218

DEVELOPMENT SERVICES DIVISION  
PERMIT SERVICES SECTION

1231 I Street, Rm. 200  
Sacramento, CA 95814 (916) 264-7619 FAX 264-7046

PLAN CHECK # \_\_\_\_\_ Insp. Area \_\_\_\_\_

Applicant MUST complete ALL Unshaded area this page only

ADDRESS 7901 Collegetauh Dr., Sacramento, CA Suite \_\_\_\_\_  
 PARCEL # 077-0010-024

**CONTACT**  
Name David Klemme  
Address 74 Digital Dr. Suite #6  
Nougto, CA Zip 94949  
Phone (415) 382-9105 FAX (415) 382-1856

**LICENSED CONTRACTOR** Lic No. 611383  
Name Environmental Resolutions AC.  
Address 74 Digital Dr. Suite #6  
Nougto, CA Zip 94949  
Phone (415) 382-9105 FAX (415) 382-1856

**ARCHITECT/ENGINEER**  
Name Delta Environmental  
Address \_\_\_\_\_  
Zip \_\_\_\_\_  
Phone (916) 536-2613 FAX \_\_\_\_\_

**OWNER**  
Name Exxon Company U.S.A  
Address P.O. Box 4286, Rm. 2675  
Houston, TX Zip 77210  
Phone (925) 246-8797 FAX (925) 246-8798

Will the permittee have any employees on the jobsite?  Yes  No

If yes, WORKER'S COMPENSATION POLICY # 1200363-98 EXPIRATION DATE: 7/1/99

NAME OF INSURANCE COMPANY: State Fund

NATURE OF WORK IN DETAIL: Install underground piping for future remediation system. from monitoring wells to vault box. Vault box installation also. See Delta Div. 43-815-5.

DBA: EXXON SIA

VALUATION: 16075


FLOOD STATUS:				S.C.A.T.						
JOB DESCRIPTION		BLDG	SHEL	APT	TI( )	REM( )	SW	FIRE	ADD	OTH
INSP. DISCIPLINES			BLDG	MECH	PLUMB	ELEC	SITE	FIRE		
# Stories	1st flr Area	Total Area	Use Zone	Occp Group	Const type	Fire Req. Y/N		Fed Code	Vio. File	
						Spr	Alarm			
B	L	P	M	E	F	S		D	R	

COMMENTS: \_\_\_\_\_

REGIONAL SANITATION FEES?  Yes  No HEALTH DEPARTMENT?  Yes  No

1620  
18

MW-3	270'
MW-5	130'
MW-6	160'
MW-10	40'
AS-1	170'
AS-2	280'
AS-3	100'
1 inch	80'
MW-1	80'
MW-2	170'
MW-7	220'
3/4 inch	
MW-1	80'
MW-2	170'
MW-7	220'

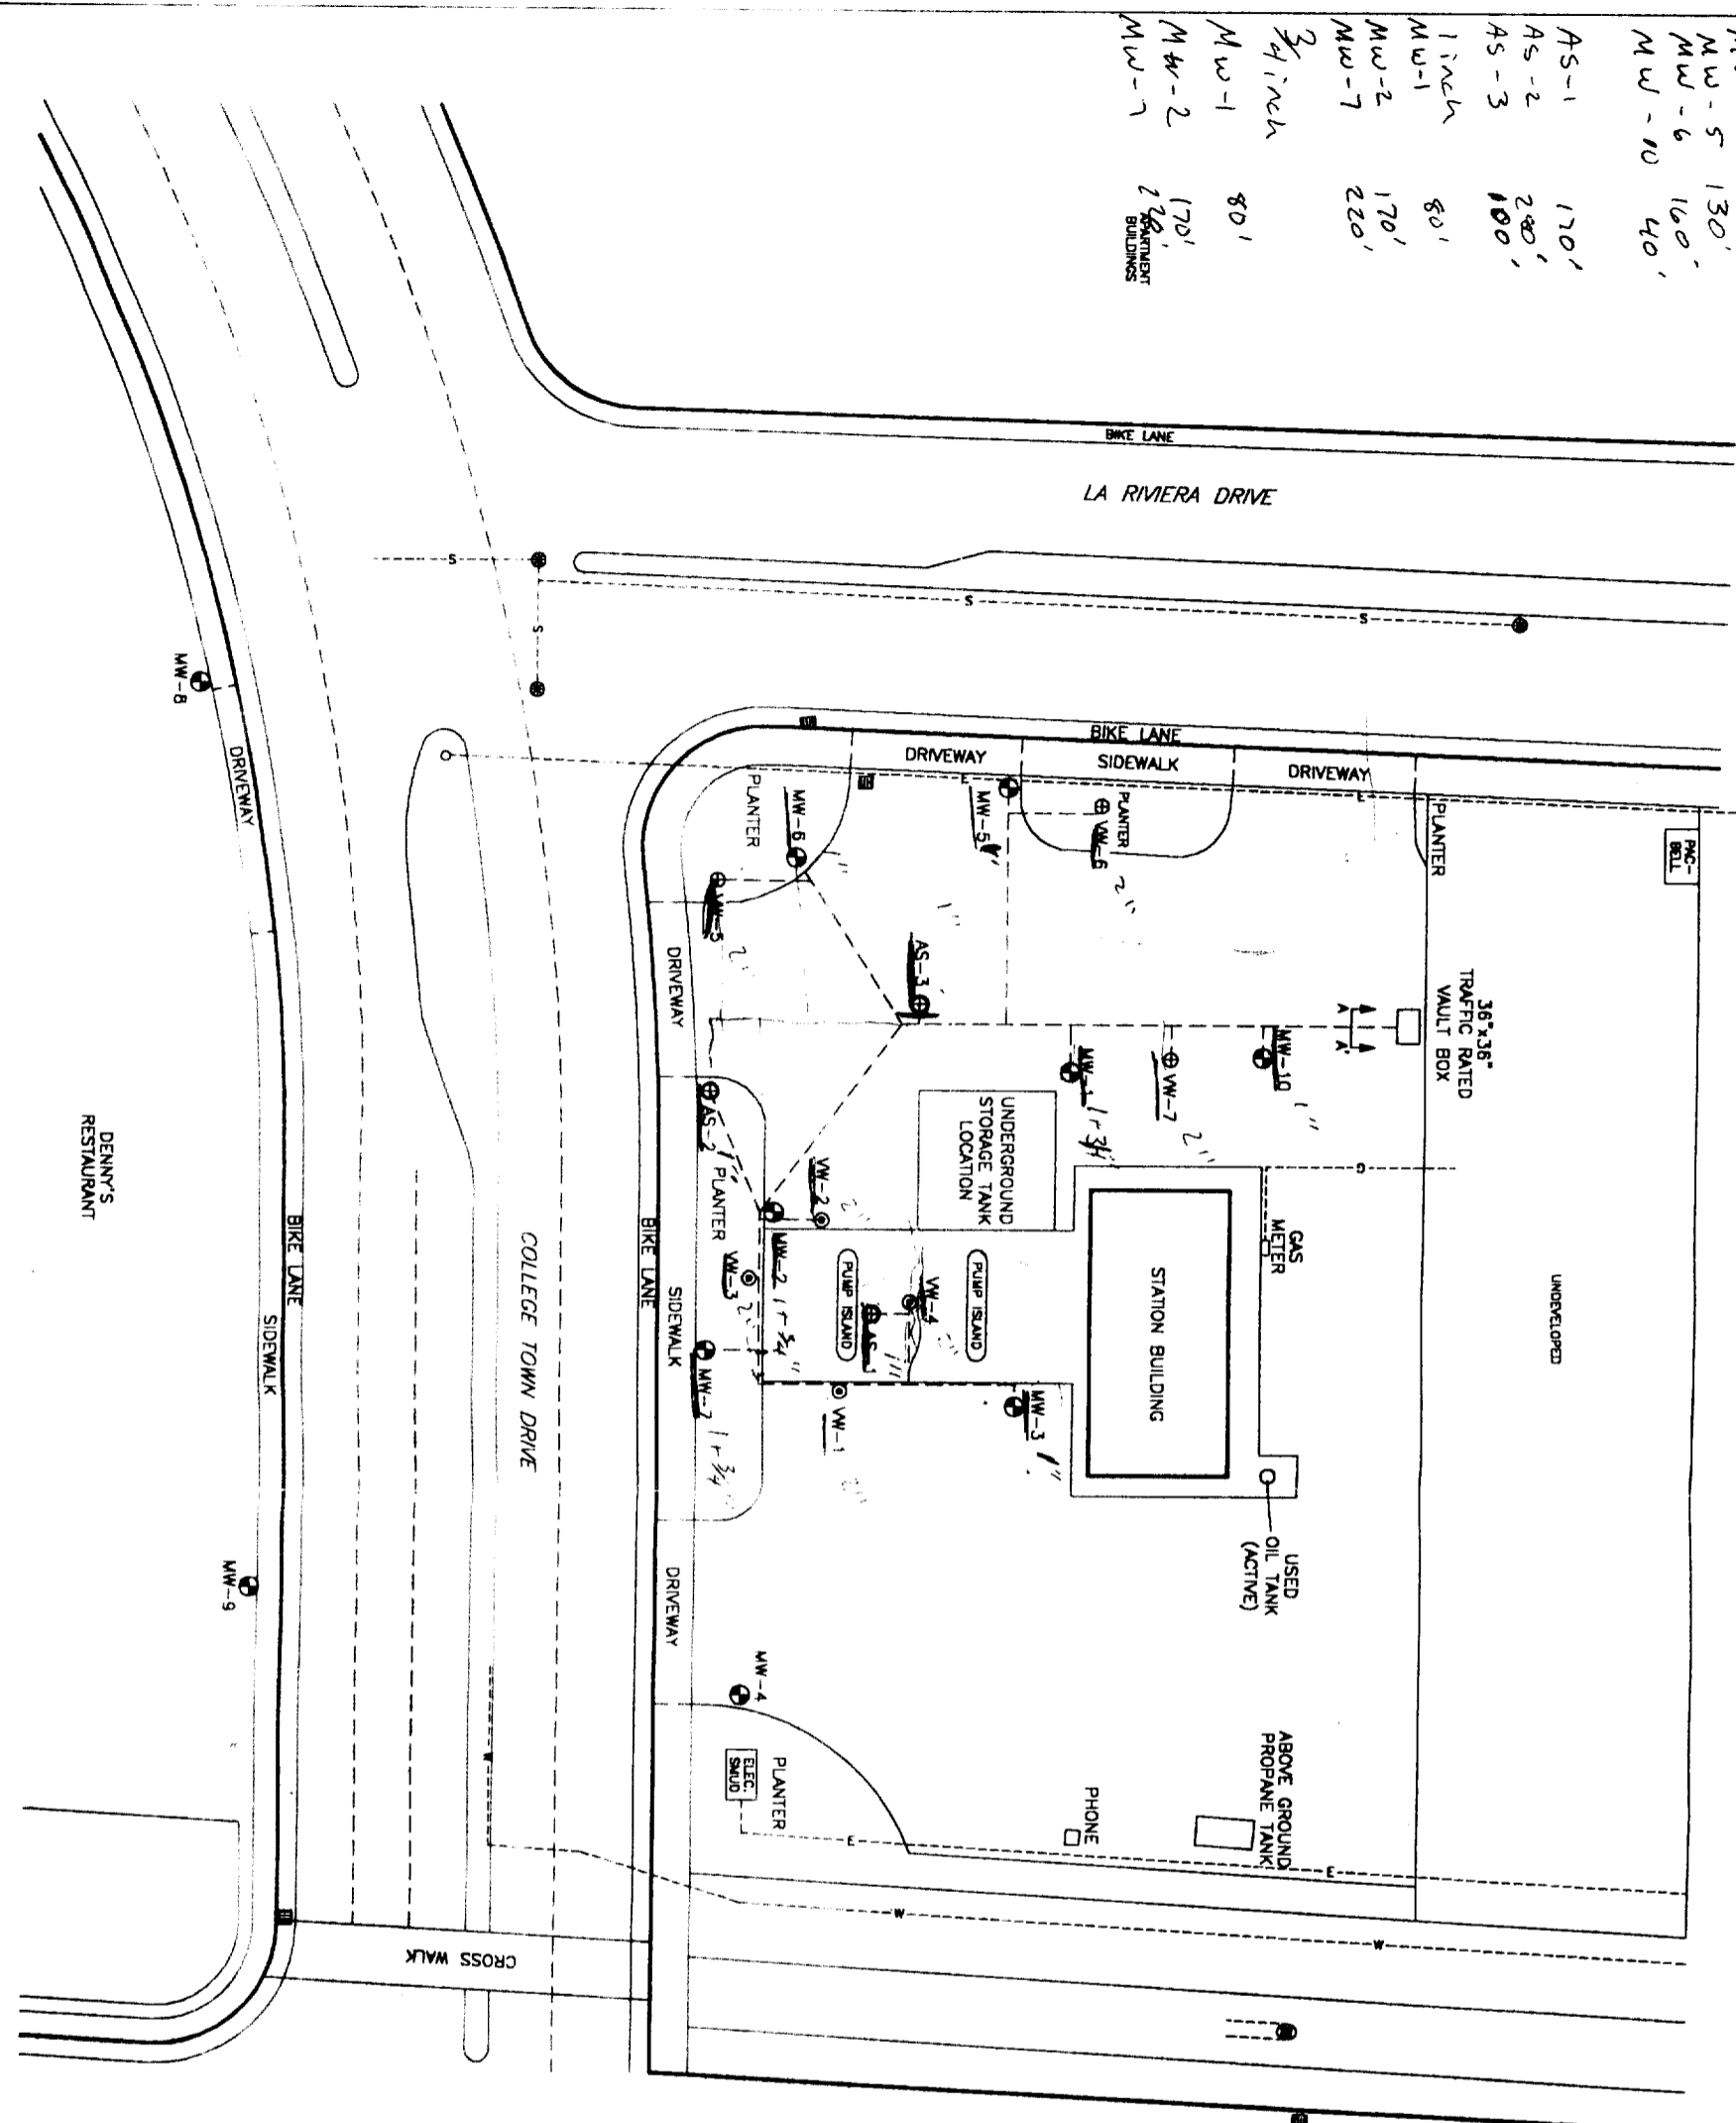

VW-1	280'
VW-2	180'
VW-3	190'
VW-4	270'
VW-5	170'
VW-6	140'
VW-7	60'

*Electrical at MW-1 (1) 3/4" Conduit MW-2 to Box ea. MW-7 Conduit only*

*The approval of all plumbing and mechanical work is subject to field inspection JMT 3/10/99*

*See permit for scope of work.*

HOWE AVENUE

- LEGEND:
- ⊕ MW-1 MONITORING WELL LOCATION
  - ⊙ VW-1 VAPOR EXTRACTION WELL LOCATION
  - ⊕ VW-6 PROPOSED VAPOR EXTRACTION WELL LOCATION
  - ⊕ AS-1 PROPOSED AIR SPARGING WELL LOCATION

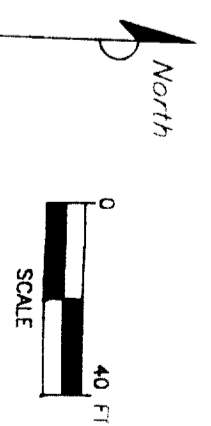


FIGURE 1

PROPOSED TRENCHING LAYOUT

EXXON STATION NO. 7-0257  
7901 COLLEGE TOWN DRIVE  
SACRAMENTO, CA.

PROJECT NO. 0093-815	DRAWN BY TJA 12/15/98
FILE NO. 83-815-1	PREPARED BY TJA
REVISION NO. 1	REVIEWED BY TJA

**Delta**  
Environmental, Inc.