

CITY OF SACRAMENTO

Permit No: 9800153

1231 I Street, Sacramento, CA 95814

Insp Area: 4

Site Address: 1560 WEST EL CAMINO AV SAC

Sub-Type: REM

Parcel No: 2740060033

Housing (Y/N): N

CONTRACTOR

OWNER

ARCHITECT

SACRAMENTO CITY EMPLOYEES RETIREMENT SYS
800
SACRAMENTO CA 95816

Phone:

Phone:

Phone:

Nature of Work: TI STARBUCKS

CONSTRUCTION LENDING AGENCY : I hereby affirm under penalty of perjury that there is a construction lending agency for the performance of the work for which this permit is issued (Sec. 3097, Civ. C).

Lender's Name _____ Lender's Address _____

LICENSED CONTRACTORS DECLARATION: I hereby affirm under penalty of perjury that I am licensed under provisions of Chapter 9 (commencing with section 7000) of Division 3 of the Business and Professions Code and my license is in full force and effect.

License Class B License Number 659107 Date 02.19.98 Contractor Signature [Signature]

OWNER-BUILDER DECLARATION: I hereby affirm under penalty of perjury that I am exempt from the contractors License Law for the following reason (Sec. 7031.5, Business and Professions Code; any city or county which requires a permit to construct, alter, improve, demolish, or repair any structure, prior to its issuance, also requires the applicant for such permit to file a signed statement that he or she is licensed pursuant to the provisions of the Contractors License Law (Chapter 9 (commencing with Section 7000) of Division 8 of the Business and Professions Code) or that he or she is exempt therefrom and the basis for the alleged exemption. Any violation of Section 7031.5 by any applicant for a permit subjects the applicant to a civil penalty of not more than five hundred dollars (\$500.00);

____ I, as a owner of the property, or my employees with wages as their sole compensation, will do the work, and the structure is not intended or offered for sale (Sec. 7044, Business and Professional Code: The Contractors Law does not apply to an owner of property who builds or improves thereon, and who does such work himself or herself or through his or her own employees, provided that such improvements are not intended or offered for sale. If, however, the building or improvement is sold within one year of completion, the owner-builder will have the burden of proving that he or she did not build or improve for the purpose of sale.)

____ I, as owner of the property, am exclusively contracting with licensed contractors to construct the project (Sec. 7044, Business and Professions Code: The contractors License Law does not apply to an owner of property who builds or improves thereon, and who contracts for such projects with a contractor(s) licensed pursuant to the Contractors License Law).

____ I am exempt under Sec. _____ B & PC for this reason: _____

Date _____ Owner Signature _____

IN ISSUING THIS BUILDING PERMIT, the applicant represents, and the city relies on the representation of the applicant, that the applicant verified all measurements and locations shown on the application or accompanying drawings and that the improvement to be constructed does not violate any law or private agreement relating to permissible or prohibited locations for such improvements. This building permit does not authorize any illegal location of any improvement or the violation of any private agreement relating to location of improvements.

Date 02.19.98 Applicant/Agent Signature [Signature]

WORKER'S COMPENSATION DECLARATION: I hereby affirm under penalty of perjury one of the following declarations:

____ I have and will maintain a certificate of consent to self-insure for workers' compensation as provided for by Section 3700 of the Labor Code, for the performance of work for which the permit is issued.

I have and will maintain workers' compensation insurance, as required by Section 3700 of the Labor Code, for the performance of the work for which this permit is issued. My workers' compensation insurance carrier and policy number are:

Carrier GOLDEN EAGLE INS. Policy Number NW054322203

____ (This section need not be completed if the permit is for \$100 or less) I certify that in the performance of the work for which this permit is issued, I shall not employ any person in any manner so as to become subject to the workers' compensation laws of California and agree that if I should become subject to the workers' compensation provisions of Section 3700 of the Labor Code, I shall forthwith comply with those provisions.

Date 02.19.98 Applicant Signature [Signature]

WARNING: FAILURE TO SECURE WORKER'S COMPENSATION COVERAGE IS UNLAWFUL AND SHALL SUBJECT AN EMPLOYER TO CRIMINAL PENALTIES AND CIVIL FINES UP TO ONE HUNDRED THOUSAND DOLLARS (\$100,000) IN ADDITION TO THE COST OF COMPENSATION, DAMAGES AS PROVIDED FOR IN SECTION 3706 OF THE LABOR CODE, INTEREST AND ATTORNEY'S FEE.

THIS PERMIT SHALL EXPIRE BY LIMITATION IF WORK IS NOT COMMENCED WITHIN 180 DAYS.

1/15/99

Date: _____

REQUEST FOR CERTIFICATE OF OCCUPANCY

- Final Certificate of Occupancy
- Extension - Temporary Certificate of Occupancy expires _____
- Temporary Certificate of Occupancy*
- Certificate of Occupancy Questions

Project Address: 1570 West El Camino ^{DBA} Starbucks
 Type of Project: (Remodel, New Construction, etc.) T1 of existing space
 Permit No(s): 98-00153
 Contact Person: Rebecca Knight
 Contact Phone No: 796-5110 FAX _____

Have ALL disciplines (INCLUDING Fire Dept. Requirements) been signed off by the inspector? Yes No N/A

*Temporary Certificates of Occupancy and extension requests are issued at the discretion of the Building Official. If there is a request for a temporary Certificate of Occupancy, or an extension of a temporary Certificate of Occupancy, explain the reason below.

COMMENTS: According to PMS, Bldg + Pmg had
Construction Notices on 4/9/98 - had
permits signed off 4-8-98?? What's up??

All requests for a Certificate of Occupancy must be approved by the Building Official.

COUNTY SANITATION DISTRICT NO. 1
 SACRAMENTO REGIONAL COUNTY SANITATION DISTRICT
SEWER IMPACT FEE
 PERMIT AND CALCULATION SHEET

APPLICATION NO: _____ BLDG PERMIT NO: CITY
 GENERAL INFORMATION
 THIS PERMIT GOOD ONLY WHEN
 VALIDATED BY THE CASHIER
 THIS PERMIT TO CONNECT EXPIRES
 ONE YEAR FROM DATE OF ISSUANCE

FEE CALCULATION		BUILDING USE	
INSPECTION	<u>6</u>	RESIDENTIAL SF <input type="checkbox"/>	MF <input type="checkbox"/>
CSD-1	<u>4835</u>	COMMERCIAL USE	UNITS
SRCSD		<u>1323</u>	<u>4</u>
CONSTRUCTION		<u>Starbucks</u>	
IN-LIEU			

TOTAL FEE \$ 4835-


APN: 274-0000-033 LOT: 1

DESCRIPTION/
 SUBDIVISION _____
 PROPERTY ADDRESS 1500 W. El Camino
 OWNER Starbucks Coffee
 MAILING ADDRESS PAY 39007
 CITY-STATE-ZIP 94111 CA 94124 PHONE _____

ADDITIONAL FEES MAY BE DUE IF CHANGES IN USE INCREASE SEWER IMPACT.
 APPLICANT SIGNATURE _____
 CONSOLIDATED UTILITY BILLING USE ONLY

ACCT _____ INPUT _____ START _____
 RECEIPT

*File
in #11 Bid
Permit Folder*

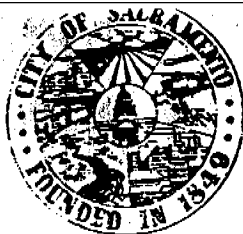

*Permit 4c
9800153*

DEPARTMENT OF
PLANNING AND DEVELOPMENT

CITY OF SACRAMENTO
CALIFORNIA

1231 I STREET
ROOM 200
SACRAMENTO, CA
95814-2998

BUILDING INSPECTIONS
916-449-5716

PLANNING
916-449-5604

NOTIFICATION
OF
CHANGE OF ADDRESS

(1560 on Permit)
Existing Address 1580 W. El Cameno Date 4-3-98

New Address add - 1570 West El Cameno

Owner STARBUCKS COFFEE CO.

Address 2401 UTAH AVE

City SEATTLE State WA Zip 98134

Legal Description A portion of 264-0060-033 -

Reason New tenant space

CITY OF SACRAMENTO
 APPLICATION FOR BUILDING PERMIT
 DEPARTMENT OF PLANNING AND DEVELOPMENT
 BUILDING INSPECTION DIVISION

1231 I Street, Room 200
 Sacramento, CA 95814
 (916) 264-7619 FAX 264-7046

9800153C

ADDRESS x 1560 W. El Camino Ave P.C. # 568
 PARCEL # 274-0060-033 SUITE # _____
 AREA # 4C

CONTACT LICENSED CONTRACTOR Lic# _____
 NAME Lisa Zenke NAME T/B/H
 ADDRESS 525 S. Douglas Ave ADDRESS _____
El Segundo ZIP 90245 ZIP _____
 PHONE 310-343 3430 FAX: 310 343 3431 PHONE() - FAX() -

ARCH/ENG OWNER
 NAME Drew and Ryan NAME Starbucks Coffee
 ADDRESS 2600 Newport Blvd Suite 130 ADDRESS 2401 Utah Ave S
Newport Beach ZIP 92663 Seattle WA ZIP 98134
 PHONE 714-675-8682 PHONE 206 447 1575 FAX 206 682-3371

WILL THE PERMITEE HAVE ANY EMPLOYEE'S ON THE JOBSITE? YES NO
 NATURE OF WORK IN DETAIL: TI of existing space

D.B.A. Starbucks VALUATION 60,000
BELOW THIS LINE FOR BLDG. DEPT. USE ONLY

FLOOD STATUS A 99 S.C.A.T.

JOB DESCR. BLDG SHEL APT ~~TR~~ REM() SW FIRE ADD OTH

INSP. DISCIPLINES BLDG MECH PLUMB ELEC SITE FIRE

# OF STORIES	AREA 1ST FL.	TOTAL AREA	OCCUP. GROUP	CONST. TYPE	FIRE SPRINK.	FIRE ALARM	FED CODE	VIO. FILE
			B	VN	Y/N	Y/N	18	
B	L	P	M	E	F	Y/N	B	R

COMMENTS:
Need Health Receipt

(REGIONAL SAN FEES? Y/N) (HEALTH DEPT? Y/N)

APPL 3/27/99
 REVISED 12/11

Worker's Comp Policy #
Company
Exp. Date

Planning Division COMMERCIAL PRELIMINARY Information Request

BUILDING CHECK ONE:

- Over the counter review and issue permit _____
- Will be taken in and reviewed for site conditions _____
- Will be taken in but not reviewed for site conditions _____
- Information only, pre-submittal information _____

Customer Name: Eric Stalle Phone Number: 310-343-3430

Project address: 1560 W. El Camino Blvd
APN: 274-0060-033 Current site use: Vacant Retail / Bar / restaurant

INITIAL Need to verify APN: _____ Proposed Site use: Coffee

Describe what is being requested: APPROVAL & COMMENTS

Requested by: RPA Date: 1-13-98

- Zone _____ Overlay / SPD / PUD / Rereview _____
- Planning staff Review required _____
 - Planning Hearing required _____
 - Design Review required _____
 - No Planning Issues
 - Counter ok review by site owner _____

Prior Applications on site P# _____ Z# _____
DR# _____ PB# _____ IR# _____

Comments: _____

Planning review by: H.P. Date: 1.13.98

- MUST BE REVIEWED BY PLANNING
- | | | |
|-----------------|----------------------|---------------|
| Care Facilities | Anything Residential | Restaurants |
| Churches | Day care | Sidewalk Cafe |
| Drive-through | Lot Line adjustments | |
| Medical Offices | Bars | |

Security codes
CELLULAR COMMUNICATION FACILITIES

TRANSMITTAL

TO:
City of Sacto Building Department
13th and I Street
Sacramento

ATTENTION: Tom Malovich *MELAVIC*

FROM:
Herb Knieriem
Glumac International
10419 Old Placerville Road, Suite 250
Sacramento, CA 95827
PHONE: (916) 362-9394
FAX: (916) 362-3306

- | | | |
|---|--|--|
| ENCLOSED: | VIA: | FOR YOUR: |
| <input checked="" type="checkbox"/> ORIGINALS | <input type="checkbox"/> MAIL | <input checked="" type="checkbox"/> APPROVAL |
| <input type="checkbox"/> PRINTS | <input type="checkbox"/> MESSENGER | <input type="checkbox"/> REVIEW |
| <input type="checkbox"/> SPECS | <input checked="" type="checkbox"/> HAND | <input type="checkbox"/> COMMENT |
| <input type="checkbox"/> DRAWINGS | <input type="checkbox"/> FACSIMILE | <input type="checkbox"/> USE |
| <input type="checkbox"/> SUBMITTALS | <input type="checkbox"/> UPS | <input type="checkbox"/> DISTRIBUTION |
| <input type="checkbox"/> _____ | <input type="checkbox"/> _____ | <input type="checkbox"/> _____ |

PROJECT: Starbucks Coffee
DATE: April 2, 1998
CC: Site

ENCLOSURES:

COPIES	DATE	NO.	DESCRIPTION
2	April 1, 1998	5	8-1/2X11 partial drawings showing revised HVAC and Loads

REMARKS:

Tom: The permit number is 9800153C the address is ~~1560B~~ W. El Camino Sacramento

*REQUIRED TO
SUBMIT PLAN REVISIONS
AND CHANGE ADDRESS AT
CITY COUNTER FOR ALL
PERMITS*

4/3/98 ✓
**ADDRESS SHOULD BE
1570**
SIGNED *[Signature]*

REVISION ON ACTIVE PERMIT

NEW PLAN CHECK NO: _____

DATE: 4-3-98

● This sheet is to be used only when a permit has been issued, is still active, and the applicant wishes to make changes to the existing approved plans.

● All revisions clouded? Yes X No _____

JOB ADDRESS 1570 West El Camino SUITE: _____ PERMIT NO. 9800153

AREA: 4c DBA: Starbucks

DESCRIPTION OF REVISIONS electrical

DISCIPLINE	B	L	P	M	<u>(E)</u>	F	S	R	D
CHECKED BY					<u>GM</u>				
ROUTE TO									
CODE					<u>13</u>				
HOURS SPENT					<u>-</u>				

CONTACT: Walt Rees

ADDRESS: 500 Giuseppe Ct #2
Roseville

PHONE: 417-7205

OF PLANS SUBMITTED: 2 SUBMITTED TO: Bill

I understand that I am responsible for all plan check fees that I incur during the course of this additional plan check and that any approved plans not claimed and paid for within 3 months of notification will be disposed of and an invoice procedure for the amount due will be initiated. I further understand that an unclaimed revision may result in delay of final approval for the subject project.

Applicant Signature

Date

DATE NOTIFIED	PLAN BIN

APPLIC. FEE	PD.

AGENCY	TOT. HRS.	TOTAL FEES
BID		
PW		
PLEASE PAY THIS AMOUNT		

CITY OF SACRAMENTO
BUILDING INSPECTION DIVISION
APPLICATION FOR BUILDING PERMIT - HAZARDOUS MATERIAL SURVEY

As Required by Assembly Bill #3205 - A Building Permit Cannot be Approved Without This Completed Form

1. Business Name: Starbucks Phone: _____
 Site Address: 1500 W. EL CAMINO AVE Suite: _____
(Street) (Zip)
 Business Owner/Representative: STARBUCKS Phone: _____
 Nature of Business: COFFEE SHOP
 Property Owner: STARBUCKS Phone: _____
 Address: 2401 UTAH AVE Suite: _____
(Street) (Zip)
SEATTLE WA 98134
(City) (State)

2. Are you developing an undetermined tenant space? Yes ___ No Is this permit for a shell building? Yes ___ No

Notify lessee of the responsibility to coordinate with the Fire Department regarding the use and handling of hazardous materials.

3. Does/Will your business generate hazardous waste? Yes ___ No

4. Does/Will your business handle, store or transport any solid, liquid, or gaseous chemicals? Yes ___ No

CONSULT THE EPA CHEMICAL LIST LOCATED AT THE BUILDING DIVISION COUNTER FOR HAZARDOUS OR ACUTELY HAZARDOUS MATERIALS TO COMPLETE THE FOLLOWING QUESTIONS.

If you answered "YES" to questions #3 and/or #4 above, continue on to questions 5 - 8.

5. Do you handle, store, or transport 55 gallons, 500 pounds, or 200 cubic feet (at Standard Temperature or Pressure) of a product or formulation containing hazardous materials at any one time? Yes ___ No ___

6. Do you handle, store or transport any amount of acutely hazardous materials? Yes ___ No ___

7. Is/Will your business be located within 1,000 feet of a school? Yes ___ No ___

If you answered "yes" to questions #6 and/or #7, complete the RMPP informational sheet.

8. Is/Will your business be located within 1,000 feet of a hospital, and/or long-term healthcare facility? Yes ___ No ___

IF YOU ANSWERED "YES" TO QUESTION #3 AND/OR #4, PLEASE CONTACT THE CITY OF SACRAMENTO FIRE DEPARTMENT LOCATED AT 1231 I STREET, SUITE 401, SACRAMENTO, CA OR CALL 449-5416.

Prior to issuance of a certificate of occupancy, each business owner(s) shall contact the City of Sacramento Fire Department and comply with the Health and Safety Code regarding the use and handling of hazardous materials:

PENALTY: Any business that violates Section 25531-25541 of the Health and Safety Code shall be civilly liable to the administering agency in an amount of not more than two thousand dollars (\$2,000) for each day in which the violation occurs. If the violation results in, or significantly contributes to, an emergency, including a fire, the business shall also be assessed the full cost of the city emergency response, as well as the cost of cleaning up and disposing of the hazardous materials. Additional liability and punishment may be assessed for knowing a violation after reasonable notice of the violation.

Applicant's Name: WALT REES
(Print)
[Signature] 02.18.98
(Signature) (Date)

BID Use Only: Plan Ck# <u>5681</u> Permit # <u>98001530</u> OK to issue prmt? <input checked="" type="checkbox"/> <u>Wen 2/18/98</u> F.D. Appr Req'd? Yes <input checked="" type="checkbox"/> No <input type="checkbox"/> <small>init date</small>	
Hold on Certificate of Occupancy? Yes <input type="checkbox"/> No <input checked="" type="checkbox"/>	
Fire Dept. Use Only: OK to issue permit? ini' ___ date ___ OK to issue Certificate of Occupancy? init ___ date ___	

RECEIPT
 ENVIRONMENTAL MANAGEMENT DEPARTMENT
 ENVIRONMENTAL HEALTH DIVISION

RECEIVED FROM: MEKENSIA DEVELOPMENT GROUP DATE: 1/13/98
 ADDRESS: 525 S DOUGLAS AVE, RT 230, EL SEGUNDO, CA 90245
 AMOUNT RECEIVED: \$ 465.00 CHECK NO.: _____ CASH
 FACILITY NAME: ST. PABLO'S COFFEE
 FAC. ADDRESS: 1560 W. EL CAMINO AVE., SAC

ENVIRONMENTAL MANAGEMENT DEPARTMENT
 RECEIVED FROM: MEKENSIA DEVELOPMENT GROUP
 DATE: 1/13/98
 AMOUNT RECEIVED: \$465.00

REVENUE DESCRIPTION: (KEY 33)

- PLAN CHECK - FOOD
- PLAN CHECK - POOLS
- PUBLIC POOL FEE (CONSTRUCTION INSPECTIONS)
- PLAN CHECK - NOISE

INDEX	REV. DETAIL	PCA	AMOUNT
6202	8817	32142	\$ 465.00
6202	8818	32142	\$
6202	8710	32131	\$
6202	8823	32233	\$

SIGNATURE: [Signature]

W:\DATA\FORMS\EHD\EHF5.FRM

White - Cashier
 Yellow - Customer
 Pink - Environmental Management Department

SRCSO

FACSIMILE TRANSMITTAL: PLEASE

DELIVER IMMEDIATELY

NUMBER OF PAGES: one

DATE: February 19, 1998

RECEIVING FAX : 264-7046

SENDING FAX : (916) 875-6253

TO: **GREG JOHNSON**
CITY OF SACRAMENTO

FROM: **CLAIR DAUGHERTY** PHONE NUMBER: (916) 875-6369
CUSTOMER SERVICE, WATER QUALITY DIVISION ENGINEERING

SUBJECT: **SEWER FACILITY IMPACT FEES** 1560 W. El Camino Ave.
APN: 274-0060-033

Plan Check - ????

The following Sewer Facility Impact fees are for Starbucks on the above site.

Inspection Fee	\$0	city
CSD-1 Fee	\$0	city
SRCSO Fee	\$4,835	
Construction	\$0	
In-lieu Fee	\$0	
	<hr/>	
	\$4,835	


This fee will increase on Feb. 28, 1998.

cc: **File**

Feb 19 '98 12:29 P. 01/01


9168756253
Fax: 9168756253

WATER QUALITY ENG

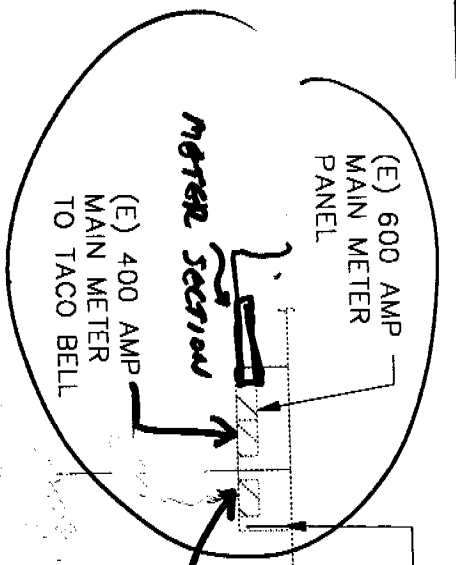


BUILDING TELEPHONE BOARD

STARBUCKS

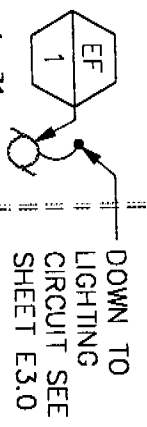


APPROVED PER 1903
 NATIONAL ELECTRICAL CODE
 AND CITY OF SACRAMENTO
 AMENDMENTS:
 4-3-98 *DA*
 ELECTRICAL DIVISION

Revision to 98-153C
Work shown is already included in permit #98-1381C

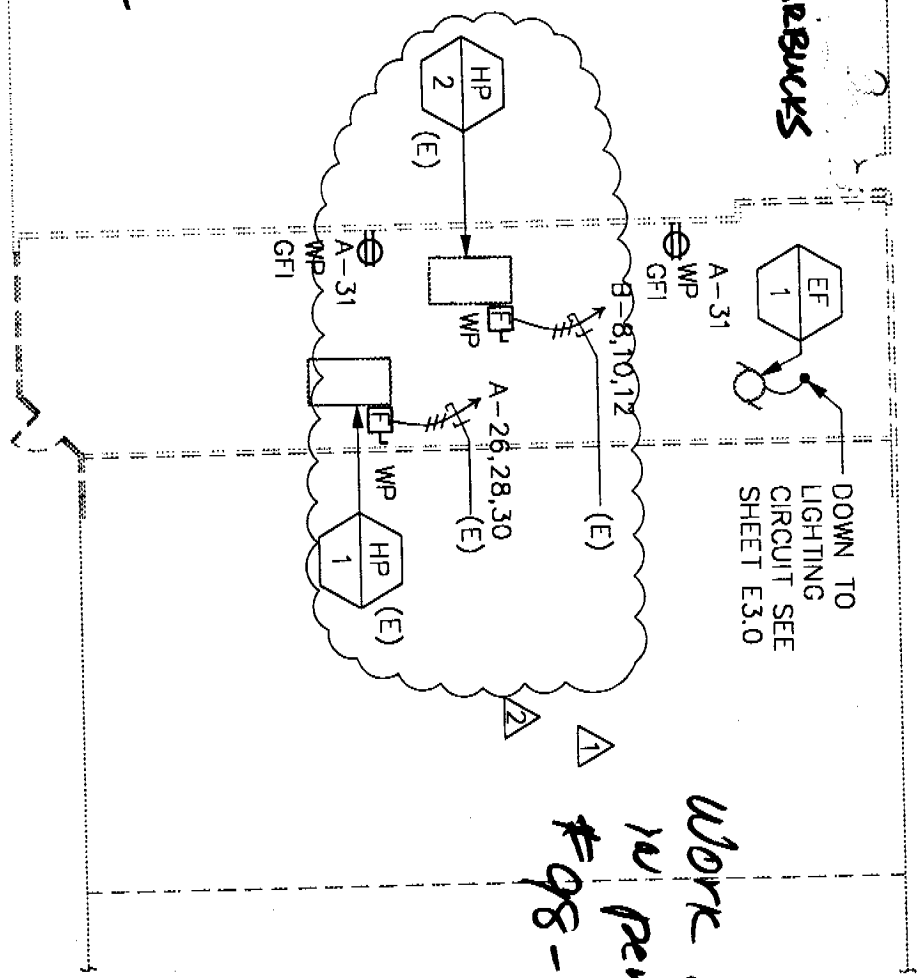


Work included in permit #98-1381C

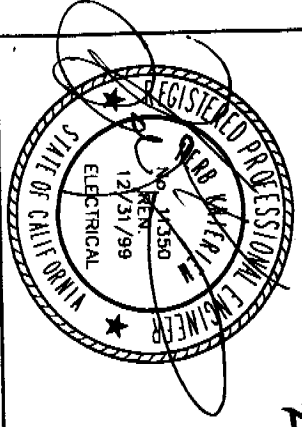

GLUMAC
 INTERNATIONAL
 CONSULTING ENGINEERS
 10419 OLD PLACEVILLE ROAD, SUITE #250
 SACRAMENTO, CA 95827-2508
 TEL 916-362-9394 FAX 916-362-3306

PROJECT		STARBUCKS - W. EL CAMINO & TRUXEL	
DRAWING TITLE		ROOF/BUILDING PLAN	
SCALE	1/8"=1'-0"	JOB NO.	
BY	JC	SHEET NO.	E4.0-2C
DATE	01APR98		

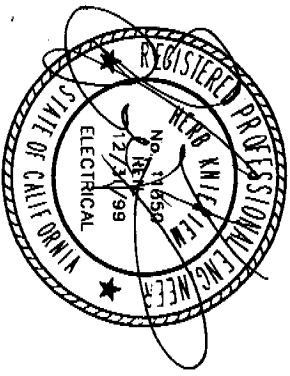

CONSULTING ENGINEERS
 10419 OLD PLACERVILLE ROAD, SUITE #250
 SACRAMENTO, CA 95827-2508
 TEL 916-362-9394 FAX 916-362-3308

GLUMAC
 INTERNATIONAL


LOAD CALCULATION

DESCRIPTION OF LOAD	KVA
LIGHTING @ 2.5 W/SF	3.2
RECEPTACLES @ 1.5 W/SF	1.2
HEAT PUMPS *	51.0
WATER HTR AND BOOSTER PUMP	0
KITCHEN EQ. @ 65% DIVERSITY	23.0
SIGNS	2.4
SPARE	4.0
TOTAL	84.8
AMPERES AT 120/208 V	233 AMPS
3 PHASE 4 WIRE	
MAIN SERVICE IS	
400 AMPERES	
* INCLUDES 25% LARGEST MOTOR	

PROJECT
 STARBUCKS - W. EL CAMINO & TRUXEL


DRAWING TITLE
 LOAD CALCULATION

SCALE NONE	JOB NO.
BY JC	
DATE 01 APR 98	SHEET NO. E4.0-2D

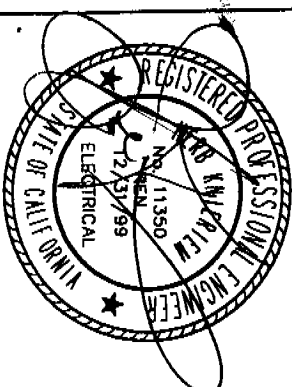

GLUMAC
INTERNATIONAL
CONSULTING ENGINEERS
10419 OLD PLACERVALE ROAD, SUITE #250
SACRAMENTO, CA, 95827-2508
TEL 916-362-9394 FAX 916-362-3306

PROJECT: STARBUCKS - W. EL CAMINO & TRUXEL
DRAWING TITLE: PARTIAL BUILDING SINGLE LINE
SCALE: NONE
BY: JC
DATE: 01APR98
JOB NO.:
SHEET NO.: E4.0-2A

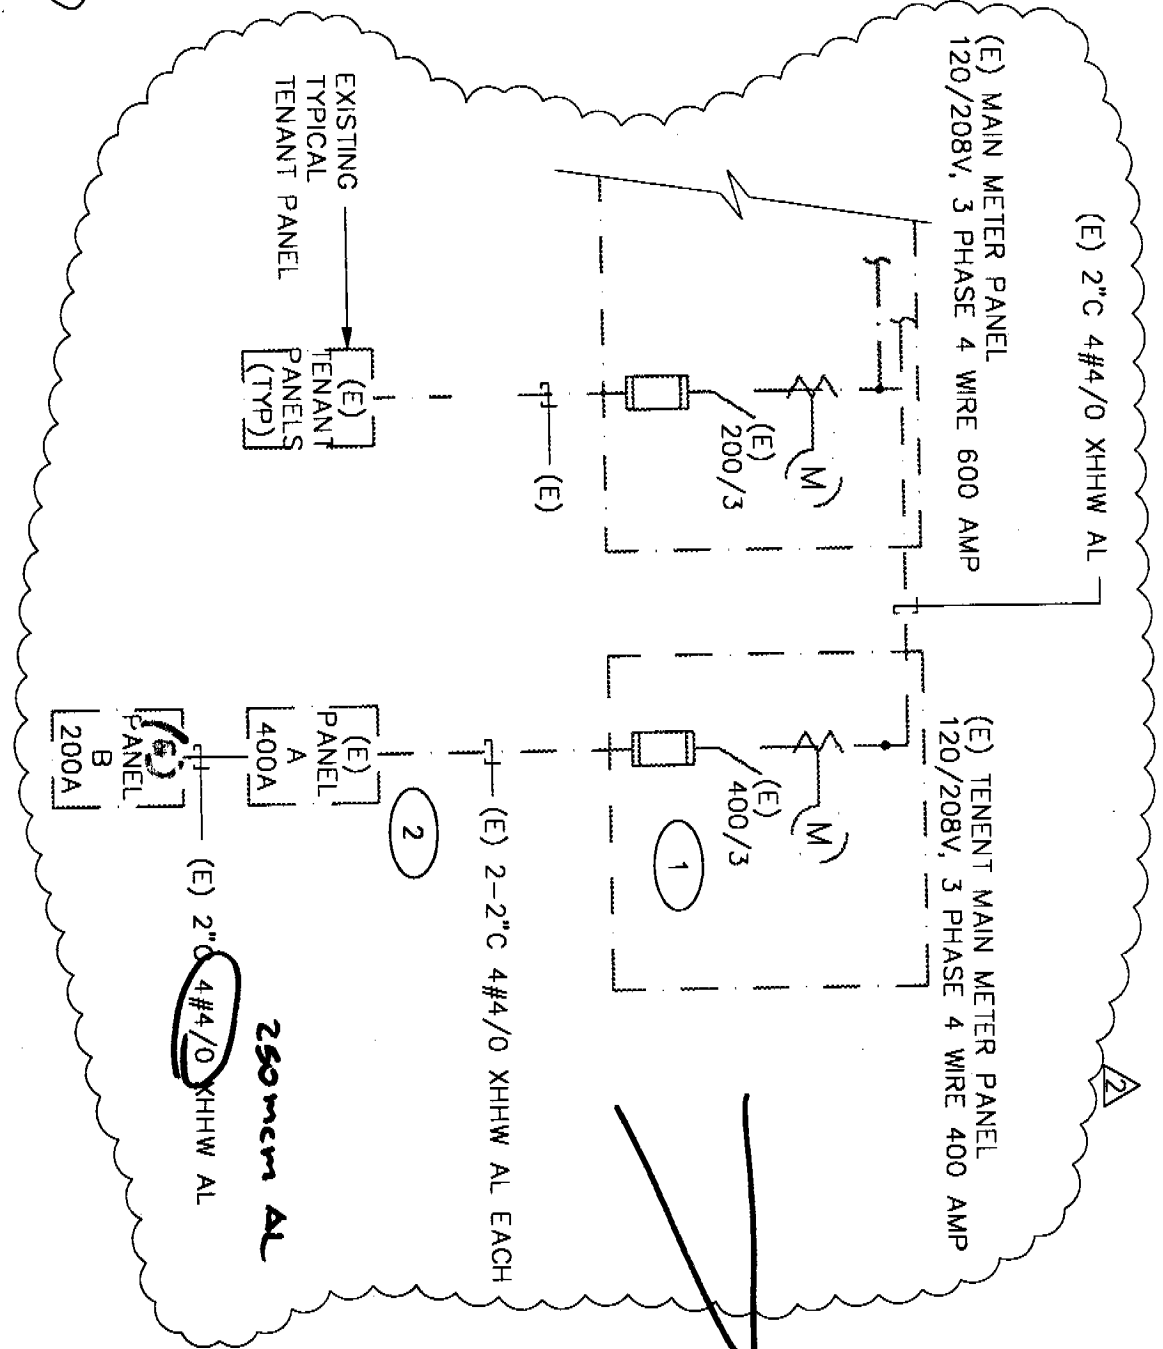

WORK Done on Permit #98-1381C

PANEL A


TYPE: NQOD
AIC: 10,000

120/208 VOLT 3 PHASE 4 WIRE
BUS: 400 AMPERE
MAIN: 400 LO

MOUNTING: RECESS
LOCATION: WORKROOM

NO	DESCRIPTION	KVA	BREAKER		TOTAL LOAD	BREAKER		KVA	DESCRIPTION	NO
			A	P		P	A			
1	LIGHTING	0.5	20	1	0.6	1	20	0.1	WATER HEATER	2
3	LIGHTING	0.9	20	1	0.9	1	20			4
5	LIGHTING	1.2	20	1	1.2	1	20			6
7	LIGHTING	0.8	20	1	2.1	1	20	1.3	GRINDER E004	8
9	LIGHTING	0.5	20	1	2.8	2	40	2.3	ESPRESSO E157	10
11	LIGHTING	1.2	20	1	3.5	-	-	2.3	ESPRESSO E157	12
13			20	1	0.5	1	20	0.5	REFRIG E301	14
15	PASTRY CASE E342	1.7	20	1	3.1	1	20	1.4	ICE MACHINE E322	16
17	MISC. RECEIPT	0.5	20	1	1.9	1	20	1.4	REFRIG E307	18
19	POS	0.2	20	1	0.4	1	20	0.2	WATER FILTER E528	20
21	POS	0.2	20	1	0.6	1	20	0.4	MISC. RECEIPT	22
23	MISC. RECEIPT	0.4	20	1	0.8	1	20	0.4	*EMER. LIGHTING	24
25	MONEY CNTR E545	0.1	20	1	9.7	3	100	9.6	**HP-1	26
27	SAFE/MUSIC	0.2	20	1	9.8	-	-	9.6	**HP-1	28
29	MANAGER DESK	0.1	20	1	9.7	-	-	9.6	**HP-1	30
31	ROOF RECEIPT	0.4	20	1	0.4	1	20			32
33	*SIGNS	1.2	20	1	1.3	1	20	0.1	SCALE E533	34
35	*SIGNS	1.2	20	1	1.2	1	20			36
37	*SECURITY SYSTEM	0.0	20	1	18.0	3	200	18.0	PANEL B	38
39	MISC. RECEIPT	0.4	20	1	19.4	-	-	19.0	PANEL B	40
41		0.0	20	1	9.0	-	-	9.0	PANEL B	42
	PHASE A	264	AMPS		32	KVA				
	PHASE B	316	AMPS		38	KVA				
	PHASE C	228	AMPS		27	KVA				
	TOTAL				97	KVA				

NOTES: *PROVIDE LOCK-ON DEVICE
**EXISTING HEAT PUMP
INCLUDES 25% LARGEST MOTOR

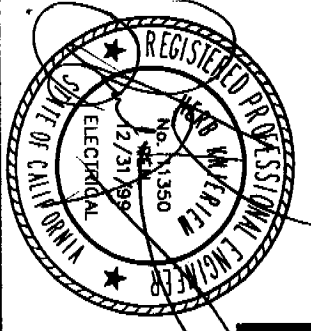

GLUMAC
INTERNATIONAL

CONSULTING ENGINEERS
1019 OLD PLAZA BLVD. SUITE #250
SACRAMENTO, CA 95827-2508
TEL 916-362-5384 FAX 916-362-3306

PROJECT: STARBUCKS - W. EL CAMINO & TRUXEL
DRAWING TITLE: PANEL A

SCALE: NONE
BY: JC
DATE: 01APR98
JOB NO.
SHEET NO. E3.0-2A


PANEL B

TYPE: NQOD
AIC: 10,000

120/208 VOLT 3 PHASE 4 WIRE
BUS: 200 AMPERE
MAIN: 200 LO

MOUNTING: SURFACE
LOCATION: WORK RM

NO	DESCRIPTION	KVA	BREAKER		TOTAL LOAD	BREAKER		KVA	DESCRIPTION	NO
			A	P		P	A			
1	TWIN COFFEE E152	3.8	40	2	9.0	2	60	5.2	DISHWASHER E451	2
3	TWIN COFFEE E152	3.8			9.0			5.2	DISHWASHER E451	4
5	WARMER E529	0.5	20	1	0.7	1	20	0.2	MENU BOARD	6
7	GRINDER E001	0.8	20	1	8.3	3	100	7.5	**HP-2	8
9	GRINDER E002	1.0	20	1	8.5			7.5	**HP-2	10
11			20	1	7.5			7.5	**HP-2	12
13	MISC RECEIPT	0.5	20	1	0.5	1	20	0.0		14
15	VITAMIX E532	1.4	20	1	1.4	1	20	0.0		16
17	MISC RECEIPT	0.4	20	1	0.4	1	20	0.0		18
19			20	1	0.0	1	20	0.0		20
21	RESTROOM RECPT	0.4	20	1	0.4	1	20	0.0		22
23			20	1	0.0	1	20	0.0		24
25			20	1	0.0	1	20	0.0		26
27			20	1	0.0	1	20	0.0		28
29			20	1	0.0	1	20	0.0		30
	PHASE A	149	AMPS		18	KVA			NOTES: **EXISTING HEAT PUMP	
	PHASE B	161	AMPS		19	KVA			INCLUDES 25% LARGEST MOTOR	
	PHASE C	71	AMPS		9.5	KVA				
	TOTAL				46	KVA				

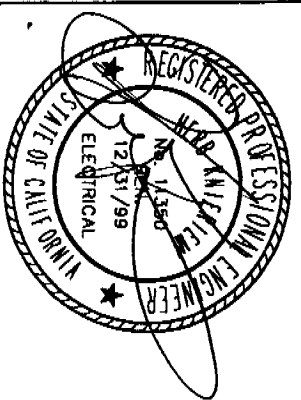

GLUMAC
INTERNATIONAL

CONSULTING ENGINEERS
10419 OLD PLACERVALE ROAD, SUITE #250
SACRAMENTO, CA 95827-2508
TEL 916-382-9384 FAX 916-382-3306

PROJECT STARBUCKS - W. EL CAMINO & TRUXEL	SCALE NONE	JOB NO.
DRAWING TITLE PANEL B	BY JC	SHEET NO. E4.0-2B
	DATE 01APR98	

CITY OF SACRAMENTO CERTIFICATE OF OCCUPANCY

For Information Contact (916) 264-5716

Building Address 1570 WEST EL CAMINO AVE. Permit No. 98-00153
Building Use restaurant/bar 30-seat DEA: Starbucks Occupancy B
Building Owner Starback's Coffee Construction Type VM
Owner Address 2401 Utah Ave., Seattle, WA 98134 Sprinkled () Yes (X) No
Portion of Building Occupied Entire Area Area 1,322 Sq. Ft.

07 / 24 / 98 BRADFORD J. BOEHM, P.E. Bradford J. Boehm, P.E.
Date Issued By: Print Sign
M. Green/Melavic City Building Official

This Certificate, issued pursuant to the requirements of Section 109 of the Uniform Building Code, certifies that at time of issuance the described portion of the building has been inspected for compliance with the Uniform Building Code as adopted per Title 9 of the Sacramento City Code for the group and division of occupancy and use for which the proposed occupancy is classified. Issuance of this certificate shall not be construed as an approval of a violation of any Codes, or Federal, State and City Laws or Ordinances. Certificates presuming to give authority to such violation shall not be valid. This certificate shall be posted in a conspicuous place on the premises and shall not be removed except by the City Building Official. No changes shall be made in the character of occupancy or use without approval of the City Building Official.

POST IN A CONSPICUOUS PLACE