

**CITY OF SACRAMENTO**  
1231 I Street, Sacramento, CA 95814

**Permit No: 0010968**  
**Insp Area: 2**

**Site Address: 7777 LARAMORE WY SAC**  
Parcel No: 053-0016-001 MEADOWVIEW VIL.-7 LOT 1

Sub-Type: NSFR  
Housing (Y/N): N

**CONTRACTOR**  
NEW FAZE DEVELOPMENT  
2377 GOLD MEADOW WY STE.270  
GOLD RIVER CA. 95670

**OWNER**

**ARCHITECT**

**Nature of Work: NSFR MP1200 6 RMS**

**CONSTRUCTION LENDING AGENCY :** I hereby affirm under penalty of perjury that there is a construction lending agency for the performance of the work for which this permit is issued (Sec. 3097, Civ. C).

Lender's Name FARMERS MERCH Lender's Address ELK GROVE, CA

**LICENSED CONTRACTORS DECLARATION:** I hereby affirm under penalty of perjury that I am licensed under provisions of Chapter 9 (commencing with section 7000) of Division 3 of the Business and Professions Code and my license is in full force and effect.

License Class B License Number 714601 Date \_\_\_\_\_ Contractor Signature Al Hammond

**OWNER-BUILDER DECLARATION:** I hereby affirm under penalty of perjury that I am exempt from the contractors License Law for the following reason (Sec. 7031.5, Business and Professions Code; any city or county which requires a permit to construct, alter, improve, demolish, or repair any structure, prior to its issuance, also requires the applicant for such permit to file a signed statement that he or she is licensed pursuant to the provisions of the Contractors License Law (Chapter 9 (commencing with Section 7000) of Division 3 of the Business and Professions Code) or that he or she is exempt therefrom and the basis for the alleged exemption. Any violation of Section 7031.5 by any applicant for a permit subjects the applicant to a civil penalty of not more than five hundred dollars (\$500.00):

\_\_\_\_ I, as a owner of the property, or my employees with wages as their sole compensation, will do the work, and the structure is not intended or offered for sale (Sec. 7044, Business and Professional Code: The Contractors License Law does not apply to an owner of property who builds or improves thereon, and who does such work himself or herself or through his/her own employees, provided that such improvements are not intended or offered for sale. If, however, the building or improvement is sold within one year of completion, the owner-builder will have the burden of proving that he/she did not build or improve for the purpose of sale.)

\_\_\_\_ I, as owner of the property, am exclusively contracting with licensed contractors to construct the project (Sec. 7044, Business and Professions Code: The Contractors License Law does not apply to an owner of property who builds or improves thereon, and who contracts for such projects with a contractor(s) licensed pursuant to the Contractors License Law).

\_\_\_\_ I am exempt under Sec. \_\_\_\_\_ B & PC for this reason: \_\_\_\_\_

Date \_\_\_\_\_ Owner Signature \_\_\_\_\_

**IN ISSUING THIS BUILDING PERMIT,** the applicant represents, and the city relies on the representation of the applicant, that the applicant verified all measurements and locations shown on the application or accompanying drawings and that the improvement to be constructed does not violate any law or private agreement relating to permissible or prohibited locations for such improvements. This building permit does not authorize any illegal location of any improvement or the violation of any private agreement relating to location of improvements.

I certify that I have read this application and state that all information is correct. I agree to comply with all city and county ordinances and state laws relating to building construction and hereby authorize representative(s) of this city to enter upon the abovementioned property for inspection purposes.

Date 10/18/00 Applicant/Agent Signature Al Hammond

**WORKER'S COMPENSATION DECLARATION:** I hereby affirm under penalty of perjury one of the following declarations:

\_\_\_\_ I have and will maintain a certificate of consent to self-insure for workers' compensation as provided for by Section 3700 of the Labor Code, for the performance of work for which the permit is issued.

I have and will maintain workers' compensation insurance as required by Section 3700 of the Labor Code, for the performance of the work for which this permit is issued. My workers' compensation insurance carrier and policy number are:

Carrier STATE FUND PAID CITY OF SACRAMENTO NEIGHBORHOODS PLANNING AND DEVELOPMENT SERVICES EXP. DATE 11-01-00  
Number 1536963-99 Exp Date 11-01-00

\_\_\_\_ (This section need not be completed if the contractor is licensed under the provisions of the Labor Code.) I certify that in the performance of the work for which this permit is issued, I shall not employ any person in any manner so as to become subject to the workers' compensation laws of California and agree that if I should become subject to the workers' compensation provisions of Section 3700 of the Labor Code, I shall forthwith comply with those provisions.

Date 10/18/00 Applicant Signature Al Hammond

**WARNING: FAILURE TO SECURE WORKER'S COMPENSATION COVERAGE IS UNLAWFUL AND SHALL SUBJECT AN EMPLOYER TO CRIMINAL PENALTIES AND CIVIL FINES UP TO ONE HUNDRED THOUSAND DOLLARS (\$100,000) IN ADDITION TO THE COST OF COMPENSATION, DAMAGES AS PROVIDED FOR IN SECTION 3706 OF THE LABOR CODE, INTEREST AND ATTORNEY'S FEE.**

**THIS PERMIT SHALL EXPIRE BY LIMITATION IF WORK IS NOT COMMENCED WITHIN 180 DAYS.**

CONSOLIDATED ENGINEERING LABORATORIES  
CONCRETE REINFORCING, POST-TENSIONING

Project Name: Rainbow Springs  
Project Address: \_\_\_\_\_  
Task: Work P/T

Date: 1/6/01 Project No.: 51737  
Inspector: Drew Robbins  
 Sampling  Inspection

- 1. Inspected materials and observed concrete placement
- 2. Visually checked joints for concrete quality
- 3. Obtained grain sample of cement
- 4. Inspected precast operation, etc.

NOTE: Take specimens from any loads suspected as being out of specification due to high slump, overtime mixing, etc.

5. Reported to: Chris  
Job site

- 14.  Returned to plant for duration of pour
- 15.  Checked ram and gauge calibration (PT)
- 16.  Inspected strapping operations, elongation form: LOTS 1 THROUGH 8

- 6. Inspected repair placement
- 7. \_\_\_\_\_
- 8. \_\_\_\_\_

17.  Elongations were within specified limits,  with the following exceptions:

- 9. Inspected placement of \_\_\_\_\_ and \_\_\_\_\_ Bars
- 10. Holddowns \_\_\_\_\_

18.  Job cancelled due to \_\_\_\_\_

- 11. Inspected loads placed at jobsite, or project \_\_\_\_\_
- 12. \_\_\_\_\_

19.  Work inspected was in compliance with approved plans and specifications:  except as noted:

- 13. Inspected jobsite grading, etc. \_\_\_\_\_
- 14. \_\_\_\_\_

20.  per approved drawings no. PT-1

- 15. Performed alignment test \_\_\_\_\_

21.  Non-Compliance Report left at jobsite (to be attached)

- 16. Performed \_\_\_\_\_ test \_\_\_\_\_

22.  hours spent performing reinspection

- 17. Performed slump test \_\_\_\_\_

Unusual circumstances or problems?  No  Yes

- 18. Test the job \_\_\_\_\_

\*Describe below. Notified: Chris  
at jobsite and \_\_\_\_\_ at DEL


- 19. \_\_\_\_\_

NOTES COMMENTS:  Continued on back of page

**FILE IN FILE**

**ALL LOTS HAD #4 HAIRPINS INSTALLED AT OUTSIDE CORNER STD 4x4 STRAPS.**  
~~LOT 1 - Box out at southwest corner not according to clearance from tendon.~~  
 - LOT 3 - Box out not according to clearance from tendon.  
~~But at front touching tendon.~~  
 - LOT 4 - Middle Box out not according to clearance.

# New Faze Development

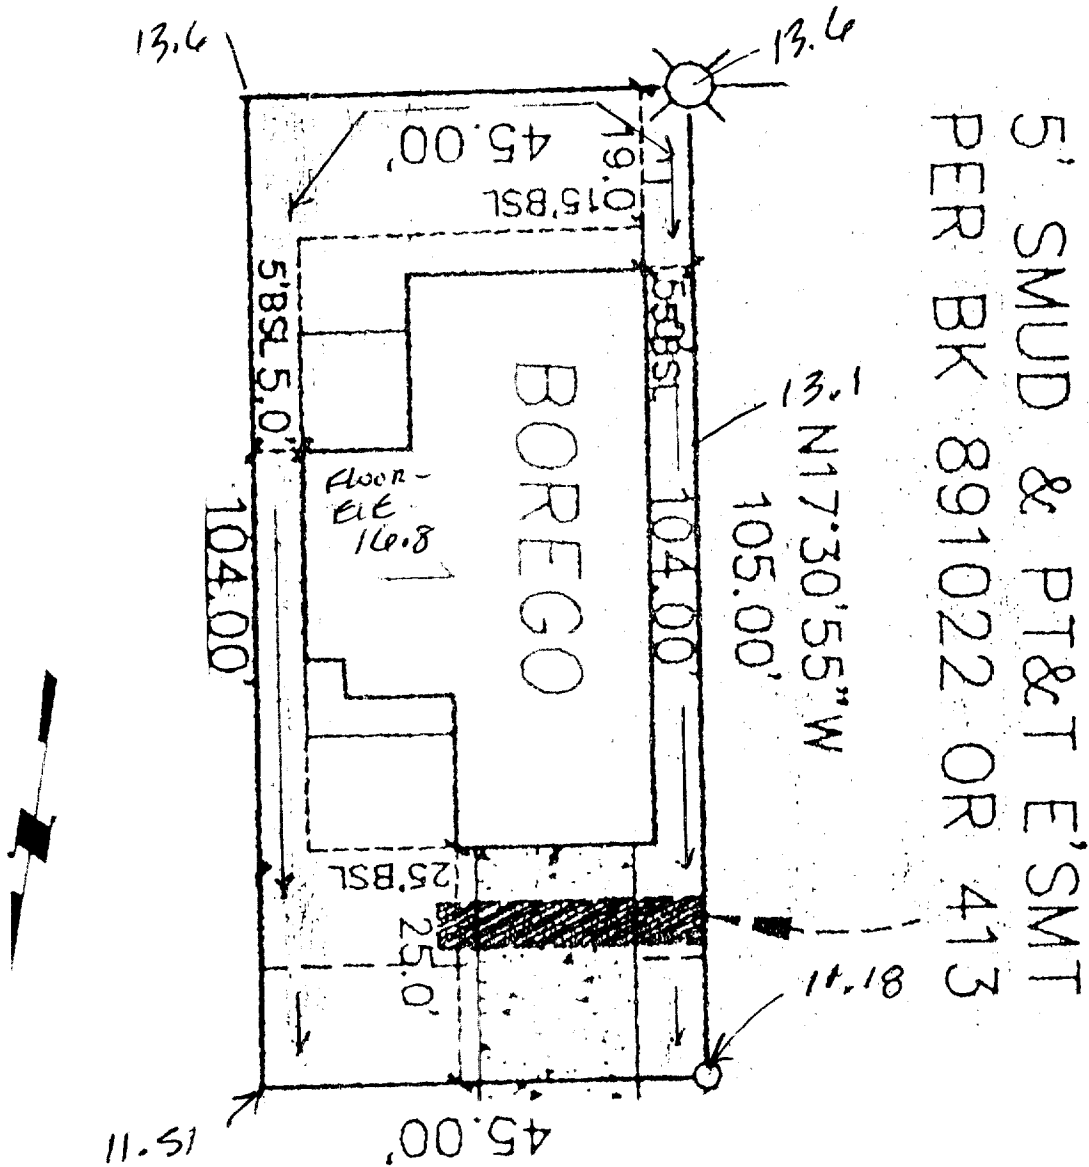

2377 Gold Meadow Way  
 Suite 270  
 Gold River, CA  
 95670-4443  
 916/924.9906  
 Fax: 916/924 9936

**RAINBOW SPRINGS**  
 Lot #001 Plan # 1232  
 7777 Laramore Way, Sacto  
 APN: 053-0016-001  
 Scale 1" = 20'