	1231 I Street, Sacramento, CA 958	814			Insp Area:	3	
					Thos Bros:	317 E1	
.) 							
	Site Address: 2664 5TH AV SAC	*		•	Sub-Type:	REM	An May 174
	Parcel No: 013-0211-009		es iver en si	Santa Santa	Housing (Y/N)	: N .	
	CONTRACTOR OF THE STATE OF THE	( 2					
1	CONTRACTOR CAPITOL RECONSTRUCTION	OWNER MEIED IAM	IES M/CHINA S		ARCHITECT		
	204 21ST ST	2664 5TH A					
	SACRAMENTO CA 95814		NTO CA 95818.			8 % - 8 <sup>3</sup>	1 12 No. 10 10 10 10 10 10 10 10 10 10 10 10 10
	Nature of Work: SMALL BATH REMOD	NET				2	1 4 S
	TVALUE OF WORK. SMALL BATH REMOD	EL			Supra Consumer Consum	7	
	CONSTRUCTION LENDING AGENCY: 1h	ereby affirm u	inder penalty of p	perjury that there is a c	onstruction lending agenc	y for the peri	formance of
	the work for which this permit is issued (Sec. 3097, Civ	C).					
	Lender's Name	<u> </u>	Lender's A	ddress		1.2 1.2	
4.3	Vignitario College						
	LICENSED CONTRACTORS DECLARATI (commencing with section 7000) of Division 3 of the Bu	ON: I herel	by affirm under	penalty of perjury th	am licensed under	provisions of	Chapter 9
i,					/// L \	0/	1
	License Class License Number 522603	_ Date	7-02 c	ontractor Signature	(OUI)		<u></u>
. :	OWNED BUILDED DECK ADAMON				- 10		<del>- the</del> end
	OWNER-BUILDER DECLARATION: I herebreason (Sec. 7031.5, Business and Professions Code; an	by affirm under	r penalty of perji	iry that I am exempt f	rom the contractors Licens	se Law for th	e following
	prior to its issuance, also requires the applicant for such	permit to file	a signed stateme	nt that he or she is lice	nsed pursuant to the prov	isions of the	Contractors
	License Law (Chapter 9 (commencing with Section 700	<ol><li>of Division</li></ol>	8 of the Busine	ss and Professions Co	de) or that he or she is ex	empt therefr	om and the
	basis for the alleged exemption. Any violation of Secti-	on 7031.5 by	any applicant for	r a permit subjects the	applicant to a civil penal	ty of not mo	re than five
-1	hundred dollars (\$500.00);				*	43	
	I, as a owner of the property, or my employees v	with wages as	their sole compe	nsation, will do the wo	ork, and the structure is no	intended or	offeredfor
	sale (Sec. 7044, Business and Professional Code: The o	Contractors Li-	cense Law does	not apply to an owner	of property who builds or	improves th	ereon, and
	who does such work himself or herself or through his/ho	er own employ	yees, provided th	at such improvements	are not intended or offere	ed for sale. I	f however
	the building or improvement is sold within one year of of the purpose of sale.)	completion, the	e owner-builder	will have the burden o	f proving that he/she did r	iot build or is	nprove for
	I, as owner of the property, am exclusively contr The Contractors License Law does not apply to an owne licensed pursuant to the Contractors License Law).	racting with liest of property v	censed contracto who builds or im	rs to construct the pro proves thereon, and w	ject (Sec. 7044, Business ho contracts for such proj	and Profess ects with a co	ions Code: ontractor(s)
	I am exempt under Sec. B &	PC for this re	ason:				
	Poten	C:			100	. g	
,	Date Ow	ner Signature_					
İ	IN ISSUING THIS BUILDING PERMIT, the applic measurements and locations shown on the application of private agreement relating to permissible or prohibited l improvement or the violation of any private agreement re	or accompany: locations for se	ing drawings an uch improvemen	d that the improvements. This building pen	nt to be constructed does	not violate a	any law or
1	I certify that I have read this application and state that all	l information is	s correct. 1 agree	to comply with all dit	y and county ordinances a	and spate laws	relatingto
	building construction and herby authorize representative	s) of this city i	to enter upon the	abovementioned prop	rty for inspection purpose	es/	
1	Date 1-4-07 App	olicant/Agent S	Signature	OMMa of	I IMMI ON	1	
	WORKER'S COMPENSATION DECLARAT I have and will maintain a certificate of consent performance of work for which the permit is issued.	to self-msure:	for workers' com	enalty of perjury one o	f the following declaration for by Section 3700 of t	ns: he Labor Co	de, for the
4	I have and will maintain workers' compensation in this permit is issued. My workers' compensation insurant	nsurance, as a ce carrier and	equired by Secti policy number ar	on 3700 of the Labore:	Code, for the performance	e of the worl	for which
	Carrier STATE COMPENSATION IN ERO		Policy Number	467-01 UNIT 0000	Exp Date	04/01/2002	
ņ	(This section need not be completed if the permit not employ any person in any manner so as to become su workers' compensation provisions of Section 3700 of the	is for \$100 or ubject to the w	orkers' compens	ation laws of Californi	a and agree that if I shoul	permit is iss become su	ued, Ishall bject tothe
r	Date 1-4-0 L App	licant Signatur	· CON	nila	flunes	\\\\	
(	WARNING: FAILURE TO SECURE WORKER'S C CRIMINAL PENALTIES AND CIVIL FINES UP TO COMPENSATION, DAMAGES AS PROVIDED FOR L	O ONE HUN	DRED THOUS	AND DOLLARS (\$	(00.000) IN ADDITION	TÔ THE	OYER TO COST OF


Permit No: 0200146

CITY OF SACRAMENTO

## CAPITOL RECONSTRUCTION CO.

Lic. #522603 204 21st Street SACRAMENTO, CA 95814 (916) 446-2774


JOB METER	2664	5th AVE	GAC.
SHEET NO.		OF	
CALCULATED BY		DATE	· ·
CHECKED BY	(1) c=	DATE	

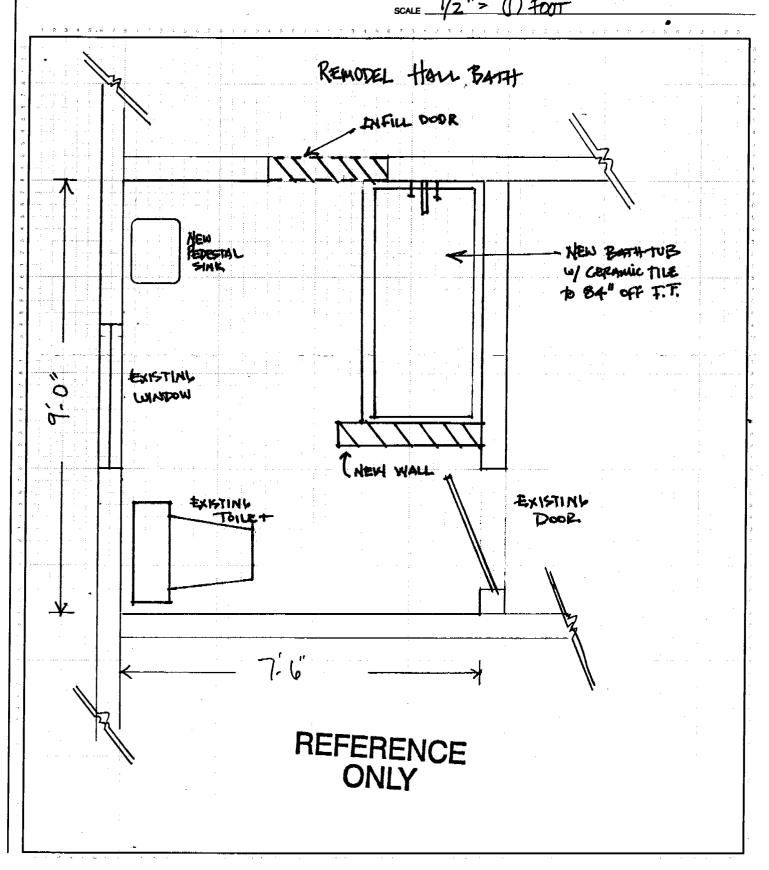

## CAPITOL RECONSTRUCTION CO.

Lic. #522603 204 21st Street SACRAMENTO, CA 95814 (916) 446-2774

JOB METER	2664	5th AVE	GAL.
SHEET NO.		OF	
CALCULATED BY		DATE	
CHECKED BY	/\ <del></del>	DATE	

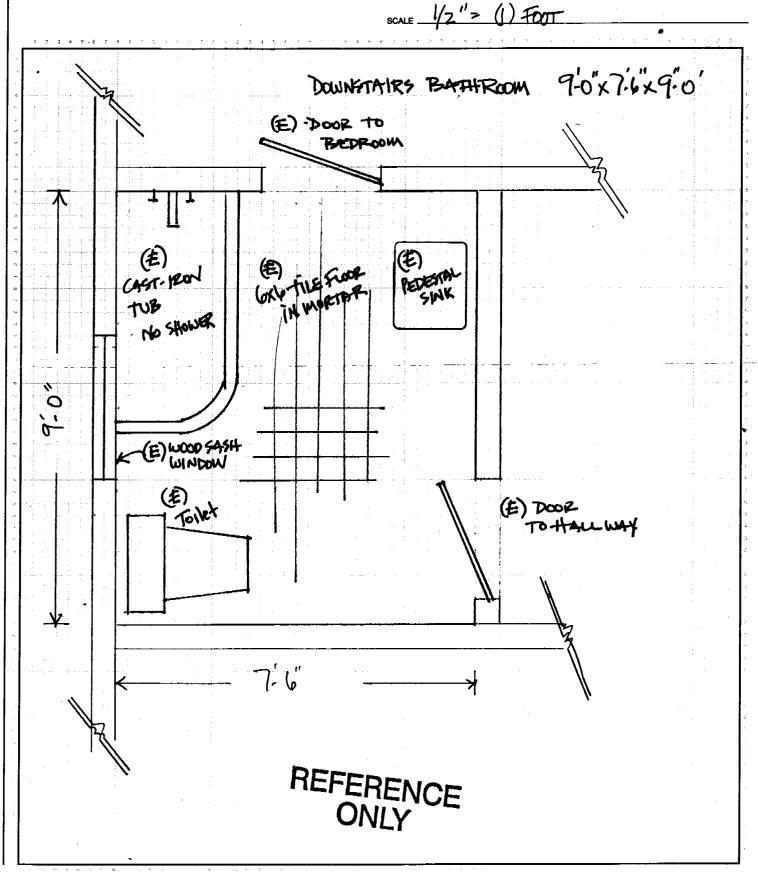

## CAPITOL RECONSTRUCTION CO.

Lic. #522603 204 21st Street SACRAMENTO, CA 95814 (916) 446-2774

JOB METER	2664	5th AVE	GAC,
SHEET NO.		OF	
CALCULATED BY		DATE	-
CHECKED BY		DATE	

