

CALL 264-5191 FOR INSPECTIONS

PERMIT SERVICES: 808-2534
HOUSING/DANGEROUS BLDG: 264-5404
FIELD OFFICE: 264-5716

01D
01F

NOTE: DO NOT COVER OR CONCEAL ANY BUILDING, ELECTRICAL, PLUMBING OR MECHANICAL WORK WITHOUT INSPECTOR'S SIGNATURE IN PROPER PLACE.

INSPECTION	INSPECTOR	DATE
B10 FOUNDATION FORMS	[Signature]	8/4/13
E60/B11 UFER GROUND	[Signature]	8/12/13
B12 CONCRETE SLAB FORMS	[Signature]	8-4-13
P40 PLUMB. UNDERFLOOR/SLAB	[Signature]	
M30 MECH/UNDERFLOOR/SLAB	[Signature]	
E61 ELECT. UNDERGROUND		
E62 ELECT. CONDUIT-SLAB		
DO NOT COVER UNTIL INSTALLATION ABOVE HAS BEEN SIGNED		
B13 FLOOR JOISTS OR GIRDERS		
DO NOT INSTALL SUB FLOOR UNTIL ABOVE HAS BEEN SIGNED		
B14/15 INSULATION/WALL/FLOOR	[Signature]	10-8-03
P41 TOP PLUMBING	[Signature]	
M31 TOP MECHANICAL/WALL/CEIL.	[Signature]	
E63 ROUGH ELECTRICAL/WALL/CEIL.	[Signature]	
B19 FRAME	[Signature]	
B17 ROOF PLYWOOD NAIL-CORRAL-FLASHES	[Signature]	9-16-03
B18 EXTERIOR LATH/SIDING	[Signature]	10-3-03
DO NOT COVER UNTIL INSTALLATION ABOVE HAS BEEN SIGNED		
B22 INT. LATH OR WALL BD. NAILING		
DO NOT TAPE PLASTER OR TOP UNTIL ABOVE HAS BEEN SIGNED		
E66 SERVICE UNDERGRD CONDUIT		
P43 SEWER SERVICE		
P42 WATER SERVICE		
P46 SPRINKLER SYSTEM		
DO NOT COVER UNTIL INSTALLATION ABOVE HAS BEEN SIGNED		
P42/M38 GAS TEST	[Signature]	10-14-03
P48 TEMP GAS	ISSUED	
E68 POWER POLE		
E67 TEMP. POWER # 2342	[Signature]	9/26/03
SWIMMING POOLS ONLY		
P47 GAS TEST		
P51 PLUMBING PRE-GUNITE		
P52 PLUMBING PRE-DECK		
E70 ELECTRICAL PRE-GUNITE		
E71 ELECTRICAL PRE-DECK		
E72 ELECTRICAL UNDERGRD		
DO NOT COVER UNTIL INSTALLATION ABOVE HAS BEEN SIGNED		
ENERGY COMPLIANCE CERTIFICATE TO BE ON FILE PRIOR TO FINAL APPROVAL.		
DATE: _____ SIGNED: _____		
FINAL APPROVALS		
B29 BUILDING	FINAL INSP. NO.	
E79 ELECTRICAL		
P59 PLUMBING		
M39 MECHANICAL		
F94 FIRE		
S92 SITE		

Address: **2360 BAYLESS WY SAC** Area: 4
Permit #: **0303343** Thomas Bros.

Location: RYLAND GARDENS/NBOROUGH II LOT G LOT 59 INSPECTIONS: 916-264-5191
APN: 201-0740-059 FIELD SERVICES: 916-808-5716
DBA:

Owner: _____

Contractor: RYLAND HOMES
3005 DOUGLAS BL. STE. 115
ROSEVILLE CA.
95661
788-8600

Sq Ft: 2466
Occupancy: _____
Const Type: _____
Comp-Type: BLD RES
Sub-Type: NSFR
Valuation: \$131,544.57

JOB DESCRIPTION: MP2015 2 STORY 7 ROOM SFR

BLDG Y MECH Y PLBG Y ELEC Y SITE FIRE N

(Firewall required behind fireplace)

WORKER'S COMPENSATION DECLARATION

I hereby affirm under penalty of perjury one of the following declarations:

I have and will maintain a certificate of consent to self-insure for workers' compensation as provided for by Section 3700 of the Labor Code, for the performance of work for which the permit is issued.

I have and will maintain workers' compensation insurance, as required by Section 3700 of the Labor Code, for the performance of the work for which this permit is issued. My workers' compensation insurance carrier and policy number are:

CITIZENS S&A MARICATO

Carrier: _____

Policy Number: _____

(This section need not be completed if the permit is for one hundred dollars (\$100) or less) I certify that in the performance of the work for which this permit is issued, I shall not employ any person in any manner so as to become subject to the workers' compensation laws of California and agree that if I should become subject to the workers' compensation provisions of Section 3700 of the Labor Code I shall forthwith comply with those provisions.

Date: _____ Applicant: _____ (Signature)

ISSUED BY:	DATE ISSUED	FED CODE
[Signature]		
	BUILDING PERMIT FEE \$	
	PLAN CHECK FEE \$	
	PROC. FEE \$	
	S.M.L. FEE \$	
	CONST. EXCISE TAX \$	
	TECH. FEE \$	
	WATER DEV. FEE \$	
	CITY SEWER DEV. FEE \$	
	REG. SEWER FEE \$	
	RESIDENTIAL CONST. TAX \$	

PERMIT NO. 02 03 03 04 02

Project Address: 2360 BAYLESS WY
Lot Number: 59

Assessor Parcel # _____
Subdivision GARDENS LOT 6 NORTHBOROUGH II

OWNER INFORMATION:

0

Legal Property Owner: Ryland Homes Phone#: 788-2633
Owner Address: 3005 DOUGLAS #115 City Roseville State CA Zip 95661

CONTRACTOR INFORMATION:

Contractor: Ryland Homes Lic. # 54648 Phone # 788-2633 Fax 784-9805

PROJECT INFORMATION: Plan Four MP 2015

Land Use Zone RIA Occupancy Group R3 Construction Type VN Fed Code 1A
No. of Stories: 2 No. of Rooms: 7 Street Width: 41'
1st Floor Area 931 2nd Floor Area 1084 Basement _____ Roof Material Tile

AREA IN SQUARE FOOT OF:

Dwelling/Living 2015
Garage/Storage 451
Decks/Balconies _____
Carports _____

SCOPE OF WORK: SFD.

FOR OFFICE USE ONLY

- Information Above Complete
- Violation Files Checked
- Standard Setbacks
- County Sewer
- AR Flood Waiver Required
- Flood Elevation Certificate Required
- Water Development Infill Area
- Planning Approval
- Design Review Approval
- Special Fee Districts Apply:

THE FOLLOWING MUST BE PROVIDED IN ORDER TO SUBMIT FOR PERMIT

- 2 COMPLETE PLOT PLANS, LEGIBLE & DRAWN TO SCALE
- 11 X 17 COPY OF FLOOR PLAN WITH FOLLOWING INFORMATION
 - a) Assessor's Parcel Number
 - b) New Floor Area
 - c) Owners Name
 - d) Project Address

Date: _____ Received by: (staff) _____ Permit # _____

CERTIFICATION OF INSULATION

PART I GENERAL

ADDRESS OR TRACT <div style="font-size: 24px; font-family: cursive; margin-top: 10px;"> RYLAND HOMES GARDEN </div>	SACRAMENTO BUILDING PRODUCTS <input type="checkbox"/> P.O. BOX 854, WEST SACRAMENTO, CA 95691 LIC. #202026 <input type="checkbox"/> 1309 MELODY ROAD, MARYSVILLE, CA 95901 LIC. #202026 <input type="checkbox"/> P.O. BOX 9651, FRESNO, CA 93793-9651 LIC. #202026 <input type="checkbox"/> P.O. BOX 1631, RENO, NV 89505 LIC. #10675 <input type="checkbox"/> 3326 A PONDEROSA WAY, LAS VEGAS, NV 89118 LIC. #10675 DATE INSULATION COMPLETED
--	---

PART II AREAS INSULATED

WALLS			CEILING			FLOORS		
(SQUARE FEET)			(SQUARE FEET)			(SQUARE FEET)		
TYPE OF INSULATION			TYPE OF INSULATION			TYPE OF INSULATION		
MATERIAL FIBERGLASS			MATERIAL FIBERGLASS			MATERIAL FIBERGLASS		
FORM BATTS			FORM BATTS & BLOW			FORM BATTS		
MANUFACTURER'S PRODUCT I.D.			MANUFACTURER'S PRODUCT I.D.			MANUFACTURER'S PRODUCT I.D.		
MANUFACTURER			MANUFACTURER			MANUFACTURER		
CT	OC	JM	CT	OC	JM	CT	OC	JM
BAGS			BAGS			BAGS		
R - VALUE INSTALLED	APPLIED THICKNESS	R - VALUE INSTALLED	APPLIED THICKNESS	MIN. INSTALLED WEIGHT PER SQUARE FOOT	R - VALUE INSTALLED	APPLIED THICKNESS	R - VALUE INSTALLED	APPLIED THICKNESS
13	3 1/2	30	9"					
19	5 1/2	30	12"					
KNEE WALLS IF R-VALUE IS OTHER THAN WALLS ABOVE								
MATERIAL FIBERGLASS		FORM BATTS		R VALUE		MANUFACTURER		
						CT	OC	JM
AIR INFILTRATION SEALANT								
MATERIAL				MANUFACTURER				
FOAM				HILTI		HANDY FOAM		

PART III CERTIFICATION

THIS IS TO CERTIFY THAT INSULATION AND/OR SEALANT HAS BEEN INSTALLED IN CONFORMANCE WITH APPLICABLE CODES, MATERIAL STANDARDS AND REGULATIONS.

SIGNATURE — INSULATION CONTRACTOR <i>JC.</i>	TITLE MANAGER	DATE 11/19/03
SIGNATURE — GENERAL CONTRACTOR	TITLE	DATE
REMARKS		

Starbuck



A.P.N.:
 ADDRESS:
 TOTAL HOUSE AREA: 2466 sq. ft.
 LOT AREA: 3170.33 sq. ft.
 LOT COVERAGE: 44.95%
 FRONT YARD PAVEMENT: 20.14%

RYLAND HOMES
 RYLAND GARDENS
 NORTHBOROUGH II LOT 6

Client/Project

Title


LOT 59
 FLOOR PLAN 4A-R
 SEPTEMBER 2002
 844 34006

Handwritten initials and marks

LEGEND:	
DI	DRAIN INLET
—x—x—	FENCE
—	SOUND WALL
—	YARD SWALE
—	SEWER SERVICE
—	WATER SERVICE
—	FIRE HYDRANT
●	HOUSE PAD ELEV.
H=13.4	FINISH FLOOR ELEV.
—	TOP OF PAVEMENT
—	THRESHOLD ELEV.
T.E.=13.5	DRIVEWAY
—	SLOPE
—	HIGH POINT
HP	GRADED ELEV.
15.5 X	

NOTE: DIMENSIONS SHOWN ARE APPROXIMATE, EXCEPT FOR MINIMUMS REQUIRED BY ORDINANCE. THIS PLAN DOES NOT REFLECT AS-BUILT CONDITIONS WHICH MAY VARY FROM THIS PLAN.

This set of plans and specifications must be read in conjunction with the zoning ordinance and specifications for the project. Any change or modification to the plans must be approved by the local authority having jurisdiction.

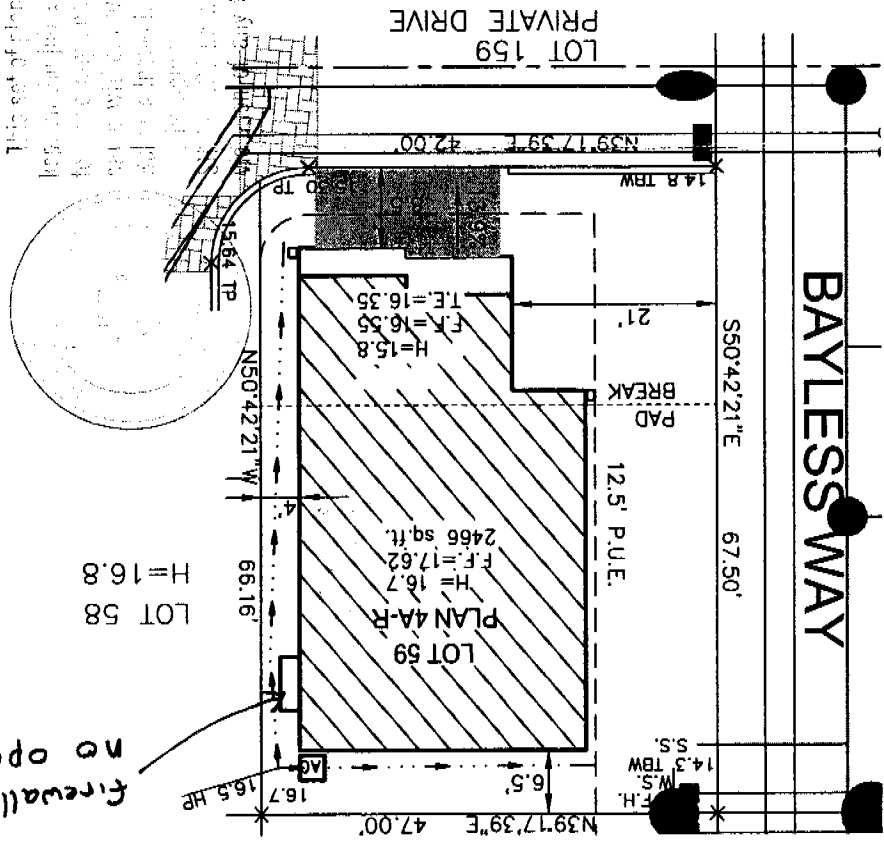

no openings
 firewall required

SCALE: 1" = 20'

