



NO PORTION OF SIGNAGE TO EXTEND MORE THAN 5" BEYOND LEASELINE, OR IN SOME CASES, FACE OF STOREFRONT POPOUT.

4'-0 1/2"  
6" 10"

11'-10" 1  
7'-0"

4'-1"

10 1/4"


# ROGGERS JEWELRY

NO EXPOSED FASTENERS ON SIGNAGE PERMITTED.

**Interior**  
REVERSE CHANNEL LETTERS - HALO ILLUMINATION  
FABRICATED STAINLESS STEEL W/ 2" RETURNS - SHINY GOLD FINISH  
FIBER OPTIC ILLUMINATION - WHITE  
MOUNT TO WOODEN FASCIA W/ 1" STAND OFF  
1" THICK FOAM DIAMOND - FACET CUT W/ SHINY SILVER WRISCO  
ALUMINUM OVERLAYS - MOUNT FLUSH ON WOODEN FASCIA  
(NON ILLUMINATED REFLECTS AMBIENT LIGHT)

SCALE: 1" = 1'

DIAMOND DETAIL  
SIDE, TOP & BOTTOM VIEW

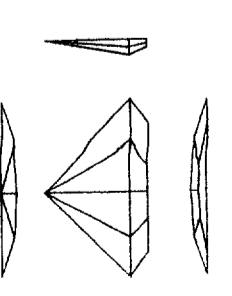

**Bill & Billie**  
SIGN DISPLAYS

916 • 924 • 1936 FAX • 916 • 924 • 3133  
1111 Joellis Way, Sacramento, CA 95815  
Contractor's License # 545167

Project: Roger's Jewelry  
Arden Fair Mall



Address: 1689 Arden Way #1334  
Sacramento, CA  
**(Revised) 2-23-01 3-13-01**

**SIGNAGE APPROVED AS NOTED**

THIS DESIGN TEAM HAS REVIEWED YOUR SUBMITTED DESIGN PLANS FOR SPACE AND COMPLIANCE WITH THE SUBSTANTIAL COMPONENTS OF THE TENANT DESIGN. APPROVAL IS FOR THE MATERIALS OF WORK AND NOT FOR THE ADDITIONAL PERMITS OR PERMITS. CONTRACTOR TO OBTAIN ALL NECESSARY PERMITS AND TO BE RESPONSIBLE FOR THE INSTALLATION OF THE SIGNAGE. ATTACHMENT OF THESE PERMITS IS REQUIRED.

3/19/01  
Shelley H. [Signature]  
Shelley H. [Signature]

REVERSE CHANNEL LETTER - HALO ILLUM.

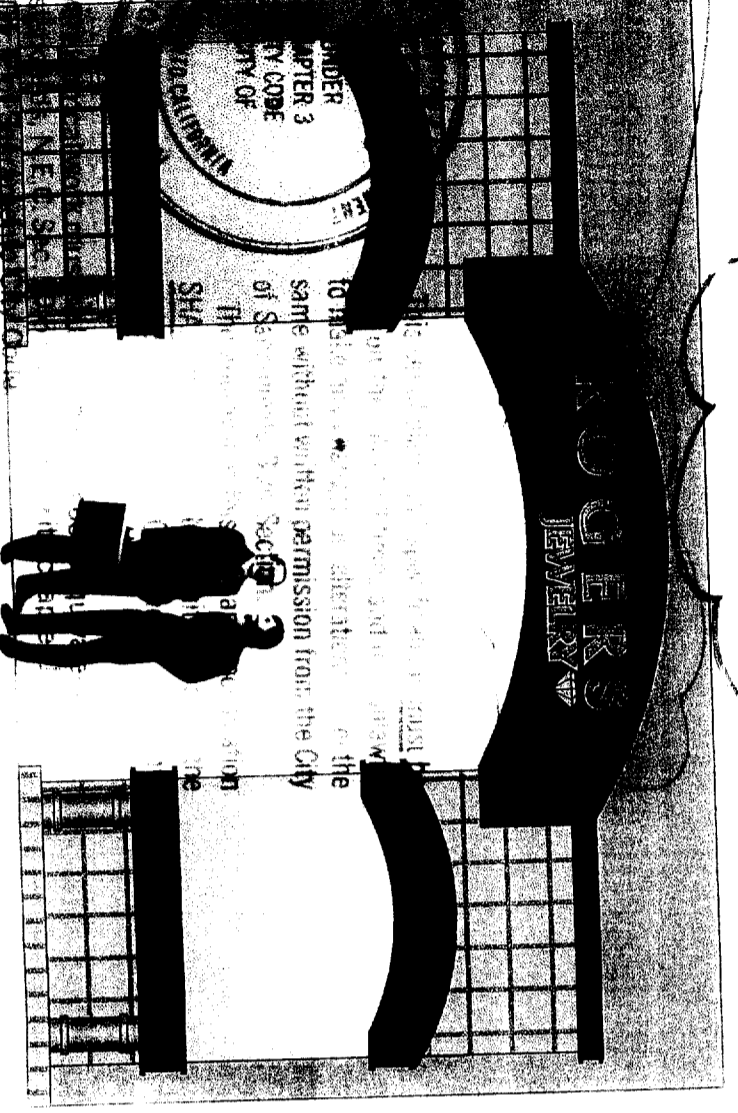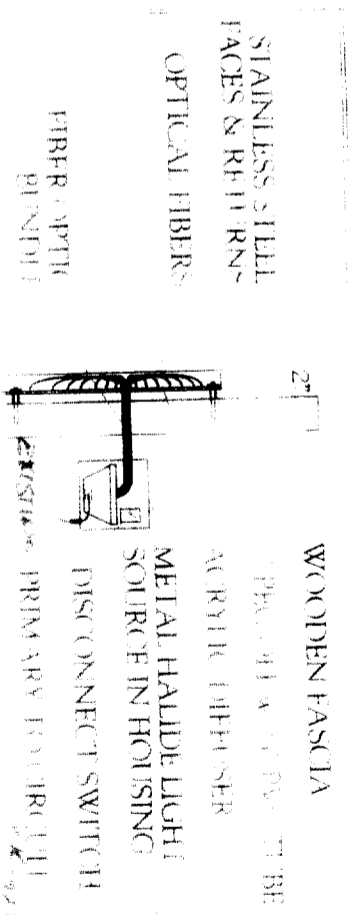

ALL SIGN INSTALLATIONS ARE SUBJECT TO FIELD INSPECTION.

FILE COPY  
FINAN COPY

All ideas, designs, arrangements, and plans informally represented by this drawing are owned by the property of Bill & Billie, and were created, evolved and developed for use on and in connection with the specified project. None of such ideas, designs, arrangements, or plans shall be used by or disclosed to any person, firm or corporation for any purpose whatsoever without the written permission of the designer. Written dimensions on these drawings shall have precedence over scaled dimensions.