


SUNGLASS HUT
WATCH STATION
SPACE #2003

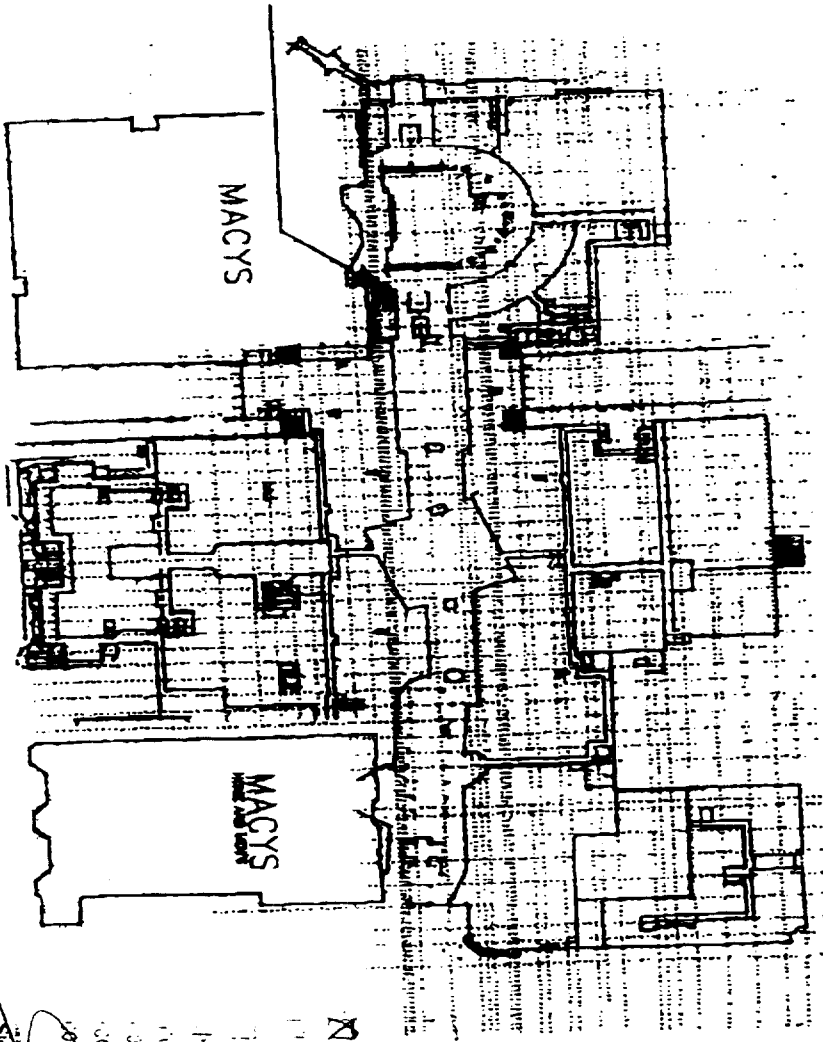

WESTFIELD, INC.
Sign Drawing Review

Approved

Approved as Noted


Resubmit



These drawings have been reviewed for general design
content only. Tenant is responsible for verification of
all conditions and compliance with government
regulations. All items in sign approval letter must be

complied with

Signed *[Signature]*

5-11-00
Date

CLIENT SUNGLASS HUT WATCH STATION	LOCATION SPACE #2003 DOWNTOWN PLAZA SACRAMENTO, CA	DATE 4-28-00	DRAWING NO. 000606	DRAWN BY K. SHAFER	 TRIANGLE SIGN & SERVICE <small>ASSOCIATION OF GRAPHIC DESIGNERS AND SIGN MAKERS OF AMERICA MEMBER SINCE 1947 SACRAMENTO, CALIF. 95811-1144</small>
SALESMAN ROBERT ALTSHULER	SCALE AS NOTED	SHEET NO. 1 OF 6	REVISED	<small>11,000 COUNCIL FOR THE CITY OF SACRAMENTO 1400 J STREET, 11TH FLOOR SACRAMENTO, CA 95811-1144</small>	

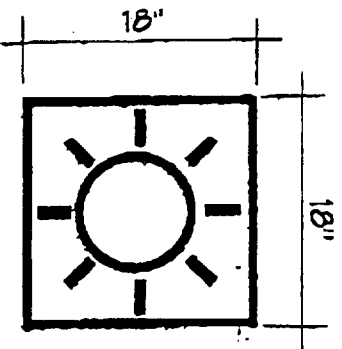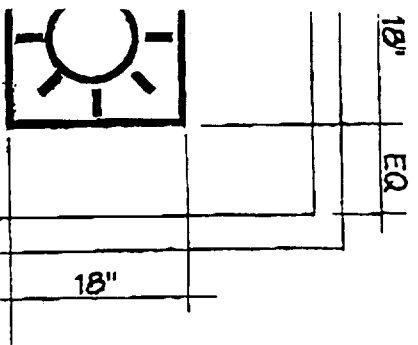

SECTION
N.T.S.


NON-ILLUMINATED DOOR LOGO (QUANTITY: 1)


SCALE: 1" = 1'-0"

3/8" THICK PLATE LOGO—
BORDER & SUNBURST
FINISHED SILVER
PIN MOUNT FLUSH TO DOOR

XK ROOM DOOR ELEVATION

1'-0"

#2003	DATE	DRAWING NO.	DRAWN BY	 TRIANGLE SIGN & SERVICE <small>11 ASHLAR COURT NOLAN, MISSISSIPPI 39208 PHONE 601-714-1310 FAX 601-714-1344</small> <small>REPRODUCTION OR VEHICLE USE WITHOUT PERMISSION OF TRIANGLE SIGN & SERVICE</small>
AZA	4-28-00	000508	K. SHAFER	
CA	SCALE AS NOTED	SHEET NO. 6 OF 6	REVISED	

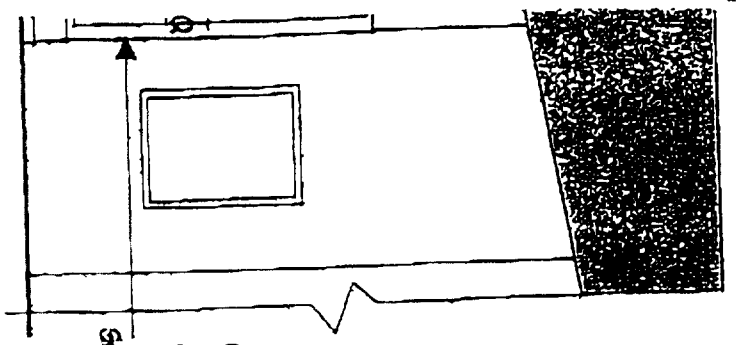

8'-9" WINDOW
ON RIGHT
RETURN WALL
EQ 8'-8" EQ
SGH W/S SGH W/S
WINDOW VINYL
(NOT SHOWN)

TRIANGLE SIGN & SERVICE

11 MOORE CENTER
P.O. BOX 15
1810 J STREET, SUITE 200
TRINIDAD, CA 94575

REPRODUCTION OF WORK
OR PART THEREOF WITHOUT
THE WRITTEN PERMISSION OF
TRIANGLE SIGN & SERVICE


WESTFIELD, INC.
Sign Drawing Review


- Approved
- Approved as Noted
- Resubmit

These drawings have been reviewed for general design intent only. Tenant is responsible for verification of field conditions and compliance with government regulations. ~~Adams~~ In sign approval letter must be complied with.

Signed *[Signature]* Date 5-11-00

TRIANGLE SIGNS Fax: 4102471944 May 9 2000 06:38 P.07

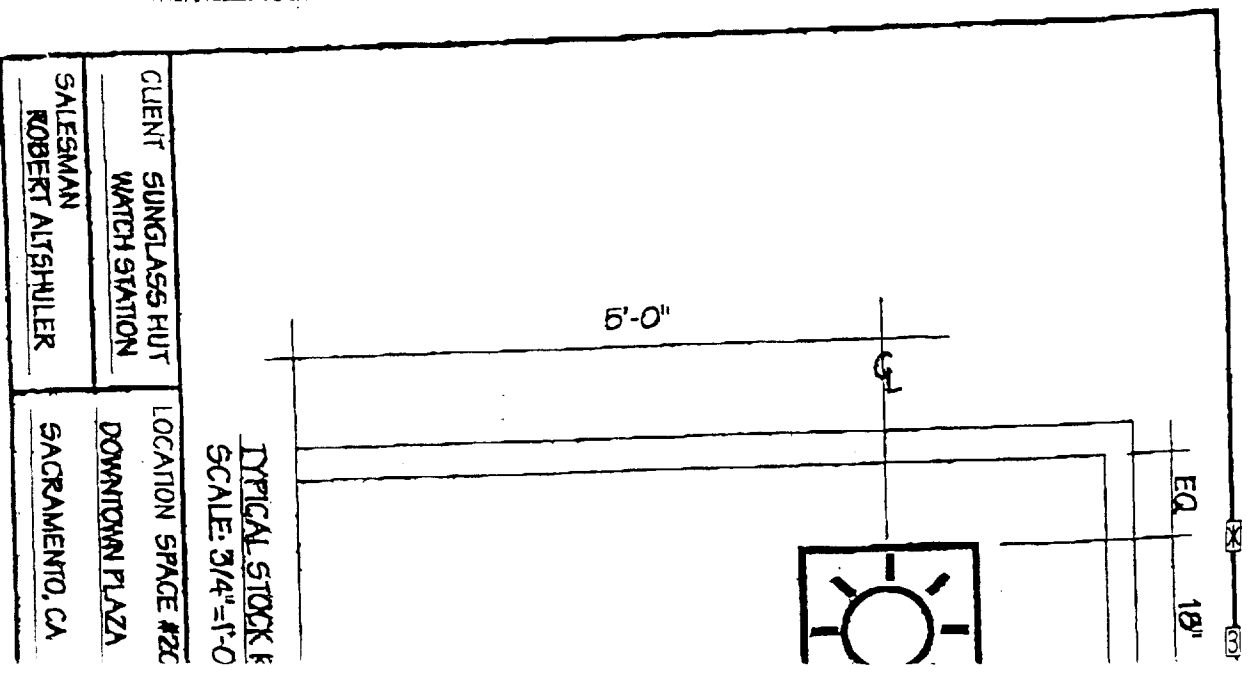

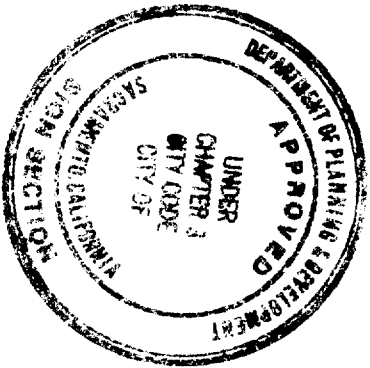


This set of plans and specifications must be kept on the job at all times and it is unlawful to make any changes or alterations from the same without written permission from the City of Sacramento Sign Section.

The approval of this plan and specification shall not be held to permit approval of any City Ordinance or State Law violation of any City Ordinance or State Law.

All electrical work must be U.L. labeled or be of equivalent standards, N.E.C. Sec. 90-6/and comply with Chapter 12, Div 2 of Sacramento City Code.


EQUIPMENT MUST BE USED AS DESIGN INTENDED. ALL SIGN INSTALLATIONS ARE SUBJECT TO FIELD INSPECTIONS.

**SUNGLASS HUT
WATCH STATION
SPACE #2003**

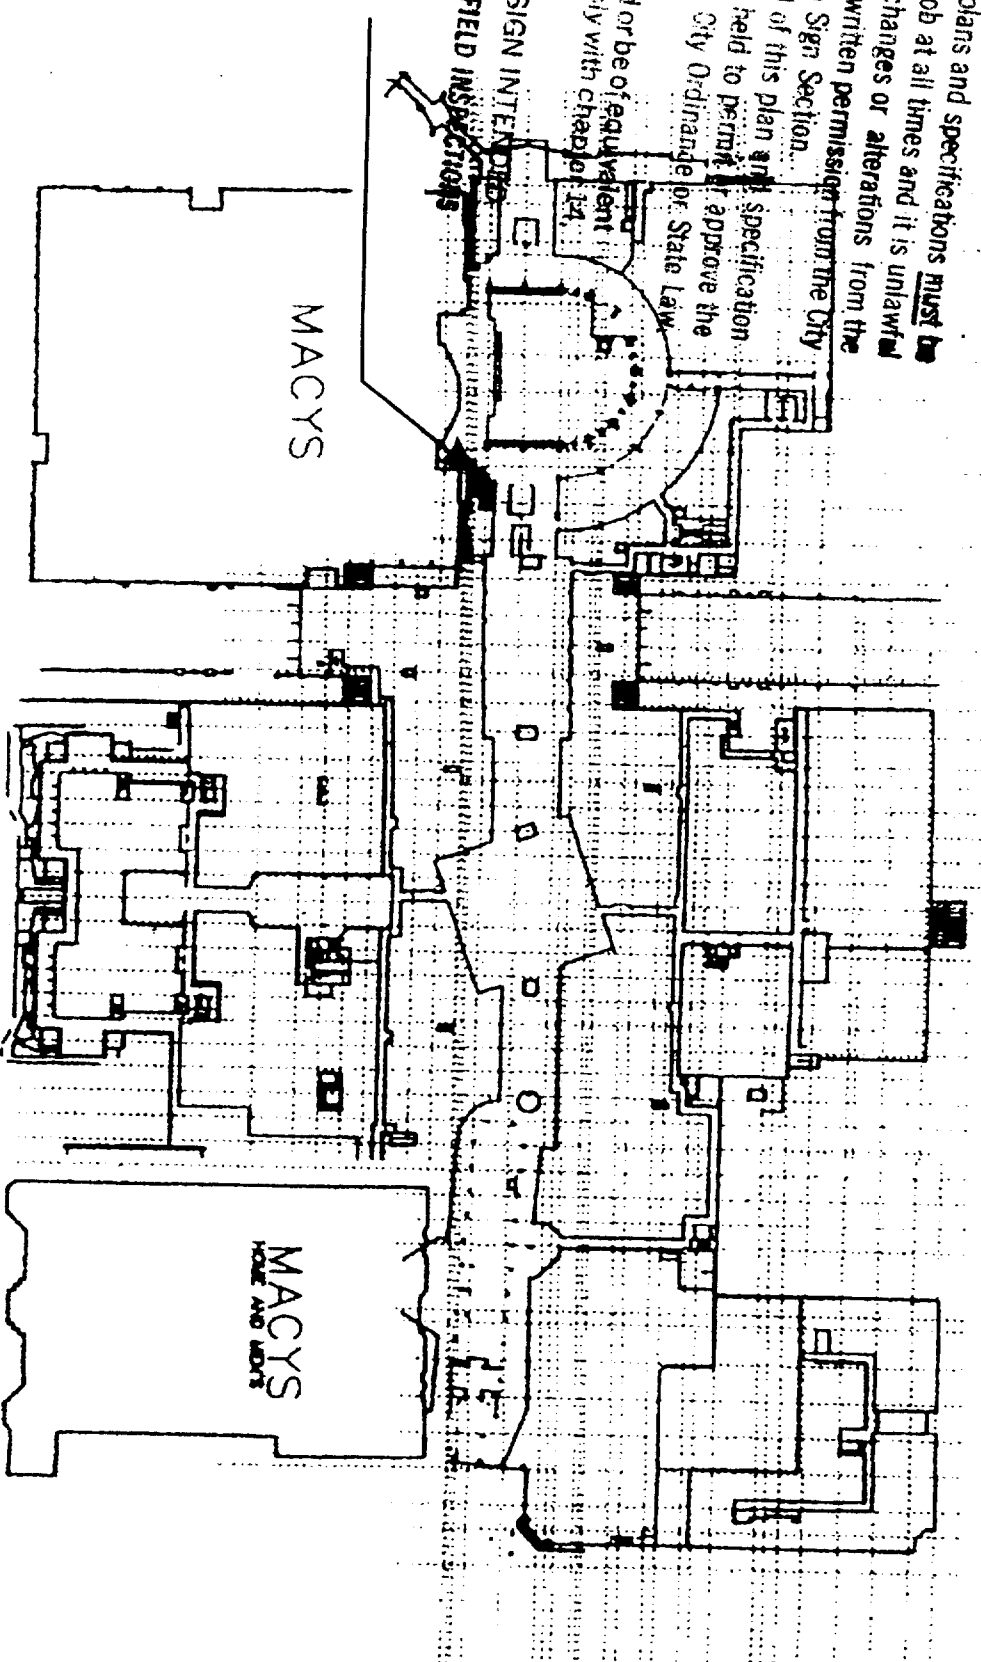


CLIENT	SUNGLASS HUT WATCH STATION	LOCATION	SPACE #2003 DOWNTOWN PLAZA SACRAMENTO, CA	DATE	4-28-00	DRAWING NO.	000506	DRAWN BY	K. SHAFER	REVISED	5-22-00	<p>TRIANGLE SIGN & SERVICE</p> <p>11 AZAR COURT P.O. BOX 24186 BALTIMORE, MARYLAND 21222 (410) 247-5300 FAX (410) 247-1944</p> <p>REPRODUCTION IN WHOLE OR PART PROHIBITED WITHOUT EXPRESS PERMISSION OF TRIANGLE SIGN & SERVICE</p>
SALESMAN	ROBERT ALTSHULER	SCALE	AS NOTED	SHEET NO.	1 OF 6	REVISED	5-22-00					


FILE COPY
S21208

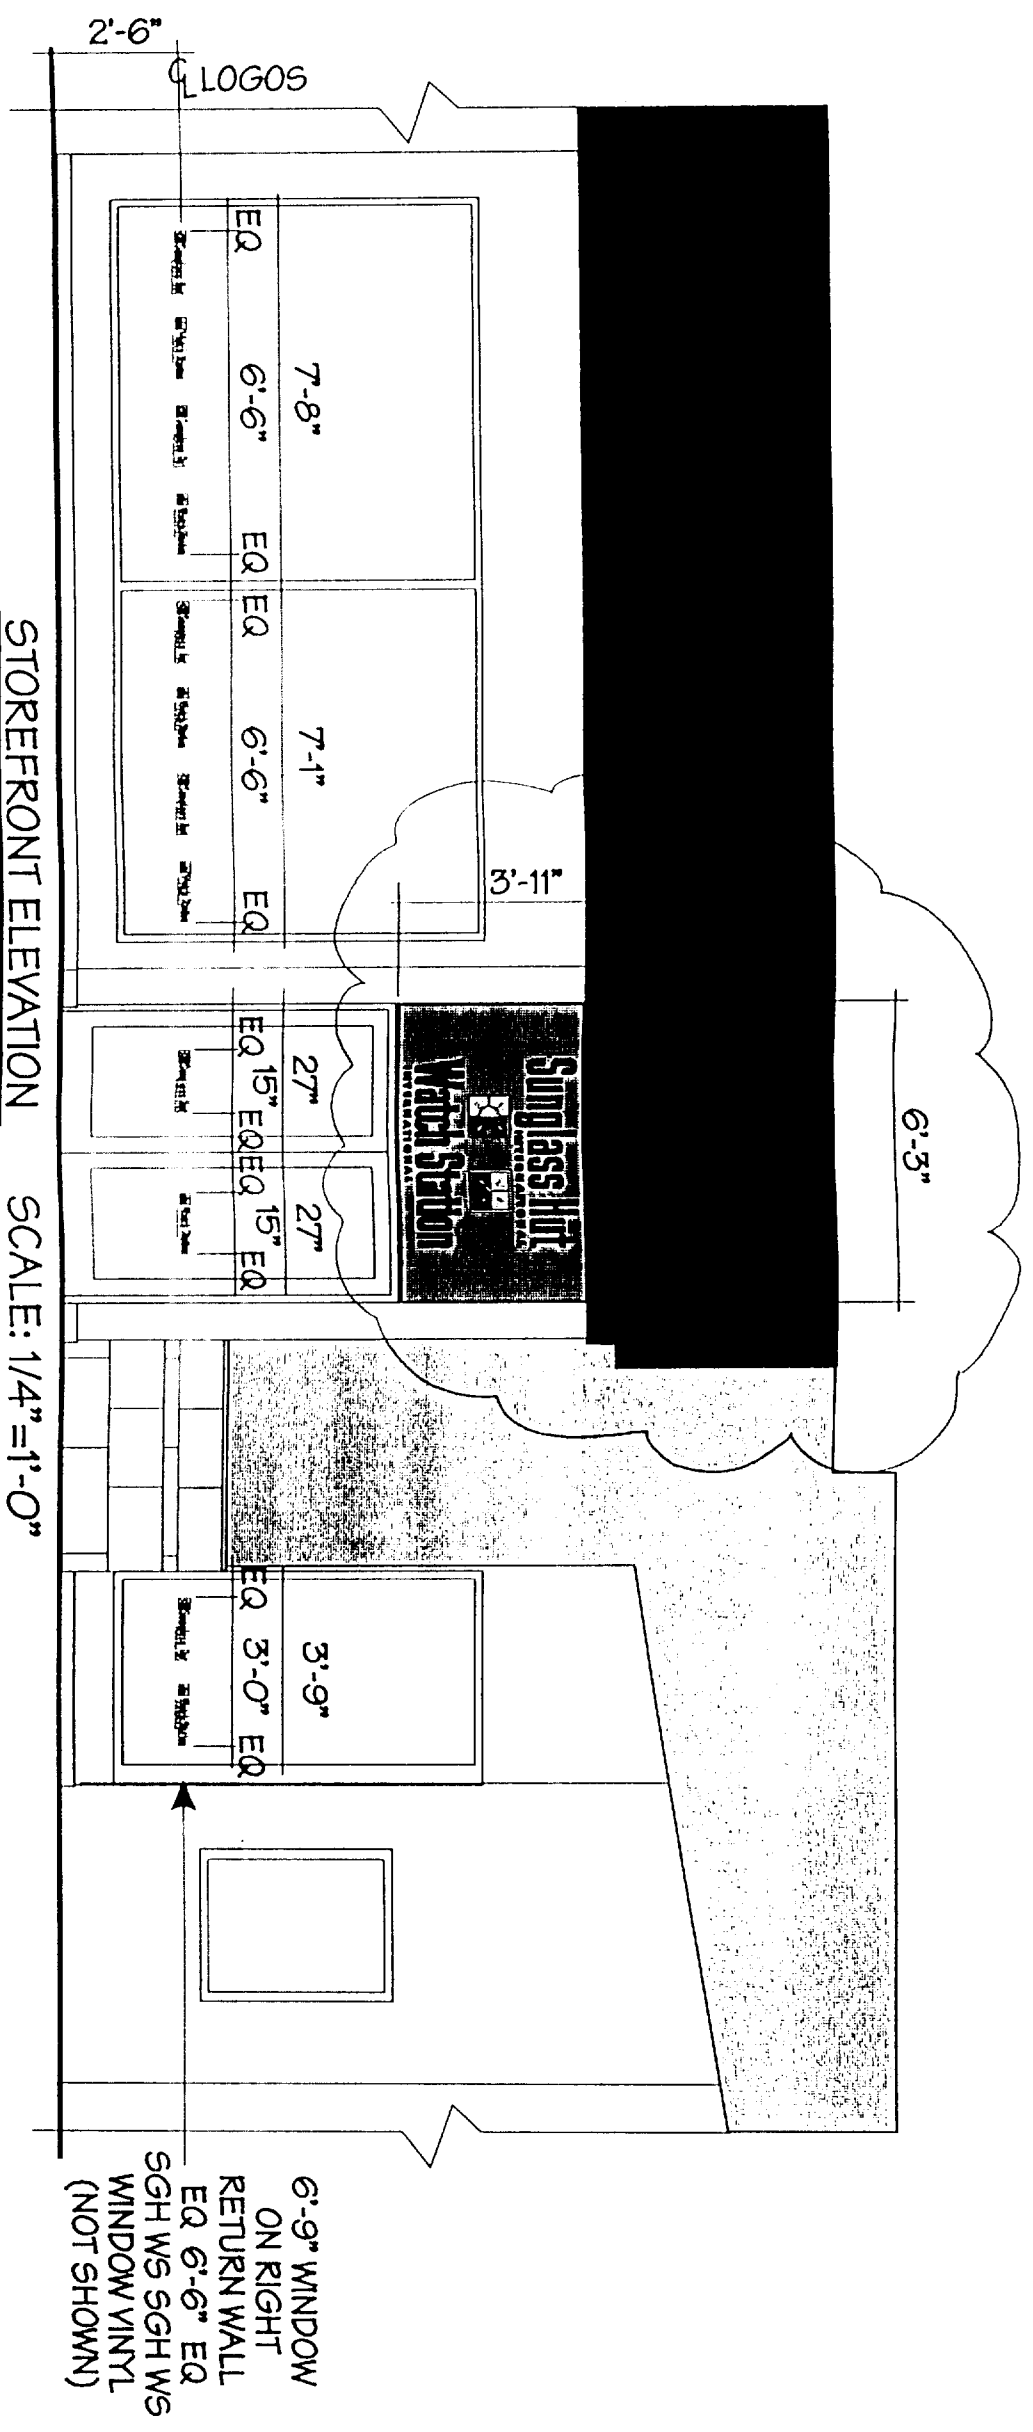

STOREFRONT ELEVATION SCALE: 1/4"=1'-0"


6'-9" WINDOW
ON RIGHT
RETURN WALL
EQ 6'-6" EQ
SGH WS SGH WS
WINDOW VINYL
(NOT SHOWN)

CLIENT SUNGLASS HUT WATCH STATION	LOCATION SPACE #2003 DOWNTOWN PLAZA SACRAMENTO, CA	DATE 4-28-00	DRAWING NO. 000506	DRAWN BY K. SHAFER	 TRIANGLE SIGN & SERVICE REPRODUCTION IN WHOLE OR PART PROHIBITED WITHOUT EXPRESS PERMISSION OF TRIANGLE SIGN & SERVICE
SALESMAN ROBERT ALTSHULER	SCALE AS NOTED	SHEET NO. 2 OF 6	REVISED 5-22-00	11 AZAR COURT P.O. BOX 24186 BALTIMORE, MARYLAND 21227 (410) 247-5300 FAX (410) 247-1944	

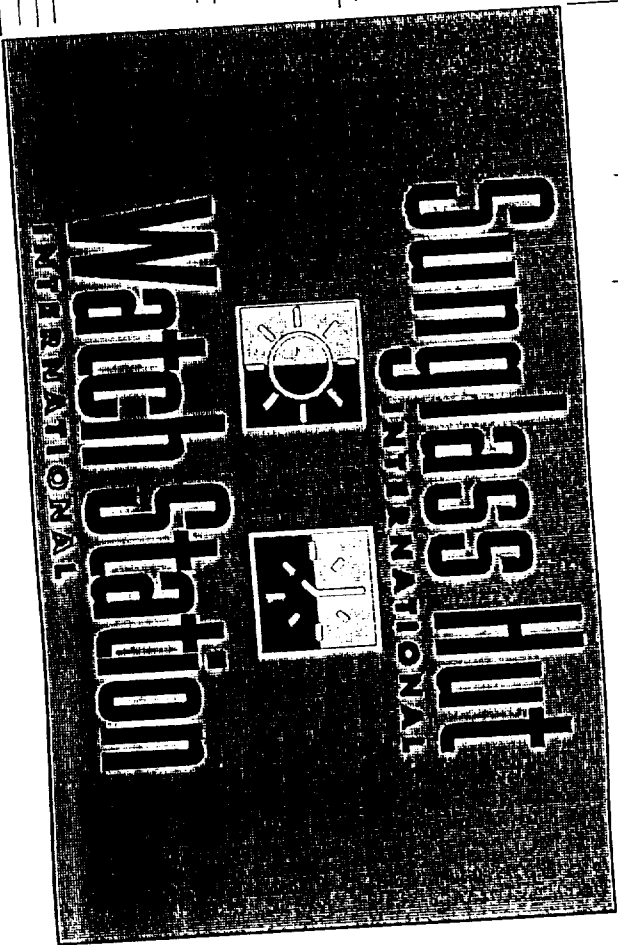

FRONT ELEVATION

TOP VIEW

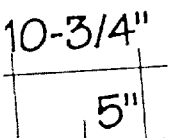

CLIENT	SUNGLASS HUT WATCH STATION	LOCATION	SPACE #2003 DOWNTOWN PLAZA SACRAMENTO, CA
SALESMAN	ROBERT ALTSHULER	DATE	4-28-00
		SCALE	AS NOTED

DRAWING NO.	000506	SHEET NO.	3 OF 6
DATE	4-28-00	SCALE	AS NOTED

DRAWN BY	K. SHAFER
REVISED	5-22-00

TRIANGLE
SIGN & SERVICE

11 AZAR COURT
P.O. BOX 24186
BALTIMORE, MARYLAND 21227
(410) 247-5300 FAX (410) 247-1944

REPRODUCTION IN WHOLE
OR PART PROHIBITED WITHOUT
EXPRESS PERMISSION OF
TRIANGLE SIGN & SERVICE

ONE (1) RADIUSED FRONT/FLAT BACK
S/F ROUTED ILLUMINATED SIGN:

SCALE: 3/4" = 1'-0"

ALUM. CABINET W/ RADIUSED ROUTED FACE FINISHED META-FLEX SILVER W/
SUNGLASS HUT LOGO: BORDER & SUNBURST--
CLEAR PUSH THRU PLEX RAISED 3/8" FROM SIGN

BACKED UP W/ WHITE PLEX
FIELD FLUSH W/ BACKGROUND
RIGHT SIDE: MATCH TRANSLUCENT PROCESS BLUE
LEFT SIDE: MATCH TRANSLUCENT ORANGE PMS #151

WATCH STATION LOGO: BORDER & CLOCK--
CLEAR PUSH THRU PLEX RAISED 3/8" FROM SIGN

BACKED UP W/ WHITE PLEX
FIELD FLUSH W/ BACKGROUND
TOP- MATCH TRANSLUCENT YELLOW PMS #116-C
BOTTOM- MATCH TRANSLUCENT BLUE PMS #660-C
'SUNGLASS HUT & WATCH STATION' - CLEAR PLEX PUSH THRU LETTERS
RAISED 3/8" FROM SIGN SURFACE
BACKED UP W/ WHITE PLEX

FACES OF LETTERS TO HAVE BLACK VINYL APPLIED
IN ORDER TO ILLUMINATE EDGES OF LETTERS ONLY
'INTERNATIONAL' (BELOW 'SUNGLASS HUT') - ROUTED & BACKED-UP
W/ MATCH TRANSLUCENT PROCESS BLUE
'INTERNATIONAL' (BELOW 'WATCH STATION') - ROUTED & BACKED-UP
W/ MATCH TRANSLUCENT PMS #660 BLUE

ILLUMINATED BY 800 MA/HO LAMPS

CLIENT SUNGLASS HUT
WATCH STATION

SALESMAN
ROBERT ALTSHULER

LOCATION SPACE #2003
DOWNTOWN PLAZA
SACRAMENTO, CA

DATE 4-28-00
SCALE AS NOTED

DRAWING NO. 000506
SHEET NO. 4 OF 6

DRAWN BY K. SHAFER
REVISED 5-22-00


TRIANGLE
SIGN & SERVICE

11 AZAR COURT
P.O. BOX 24186
BALTIMORE, MARYLAND 21227
(410) 247-5300 FAX (410) 247-1944

REPRODUCTION IN WHOLE
OR PART PROHIBITED WITHOUT
EXPRESS PERMISSION OF
TRIANGLE SIGN & SERVICE


EXISTING ELECTRICAL CIRCUIT

T.M. 5-30-2000
The approval of an Electrical Inspector is subject to field inspection.

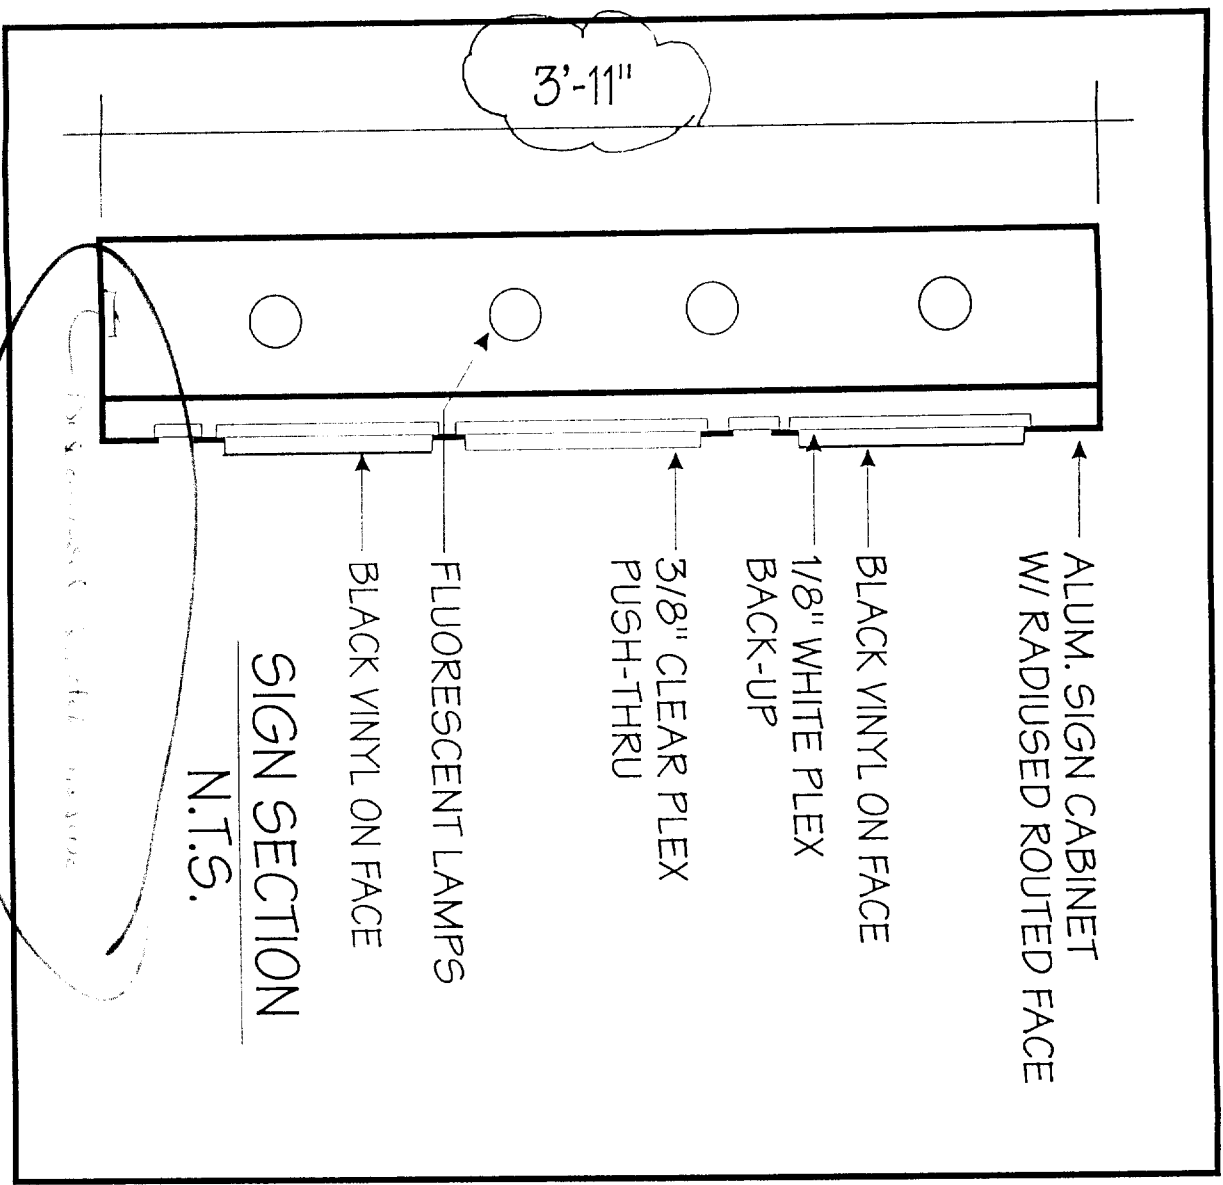

SIGN SECTION
N.T.S.


REPRODUCTION IN WHOLE
OR PART PROHIBITED WITHOUT
EXPRESS PERMISSION OF
TRIANGLE SIGN & SERVICE

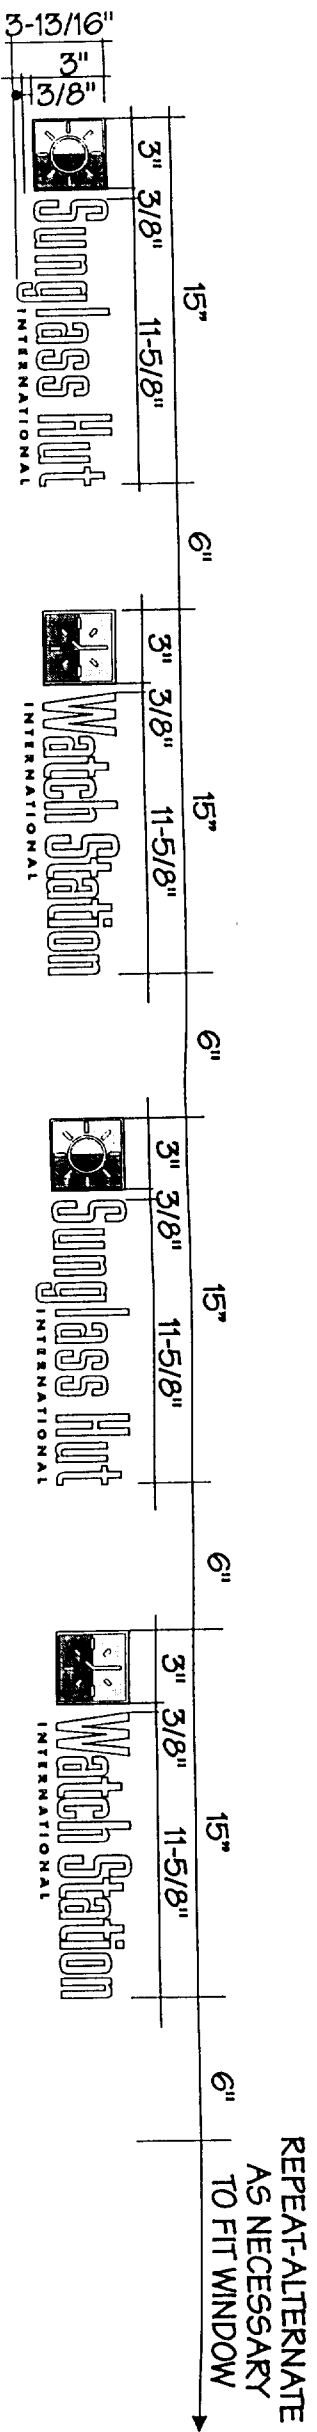


REPEAT-ALTERNATE
AS NECESSARY
TO FIT WINDOW



WINDOW VINYL LOGOS & LETTERS:
SCALE: 1-1/2" = 1'-0"

REVERSE CUT VINYL APPLIED TO INSIDE OF WINDOWS
SUNGLASS HUT LOGOS: BORDER & SUNBURST-- WHITE
RIGHT SIDE: MATCH PROCESS BLUE
LEFT SIDE: MATCH ORANGE PMS #151
"SUNGLASS HUT"-- WHITE
"INTERNATIONAL"-- MATCH PROCESS BLUE
WATCH STATION LOGOS: BORDER & CLOCK- WHITE
TOP- MATCH YELLOW PMS #116-C
BOTTOM- MATCH BLUE PMS #660-C
"WATCH STATION"-- WHITE
"INTERNATIONAL"-- MATCH PMS #660-C BLUE


CLIENT	SUNGLASS HUT WATCH STATION	LOCATION	SPACE #2003 DOWNTOWN PLAZA SACRAMENTO, CA	DATE	4-28-00	DRAWING NO.	000506	DRAWN BY	K. SHAFER	 TRIANGLE SIGN & SERVICE 11 AZAR COURT P.O. BOX 24186 BALTIMORE, MARYLAND 21227 (410) 247-5300 FAX (410) 247-1944 REPRODUCTION IN WHOLE OR PART PROHIBITED WITHOUT EXPRESS PERMISSION OF TRIANGLE SIGN & SERVICE
SALESMAN	ROBERT ALTSHULER	SCALE	AS NOTED	SHEET NO.	5 OF 6	REVISED				

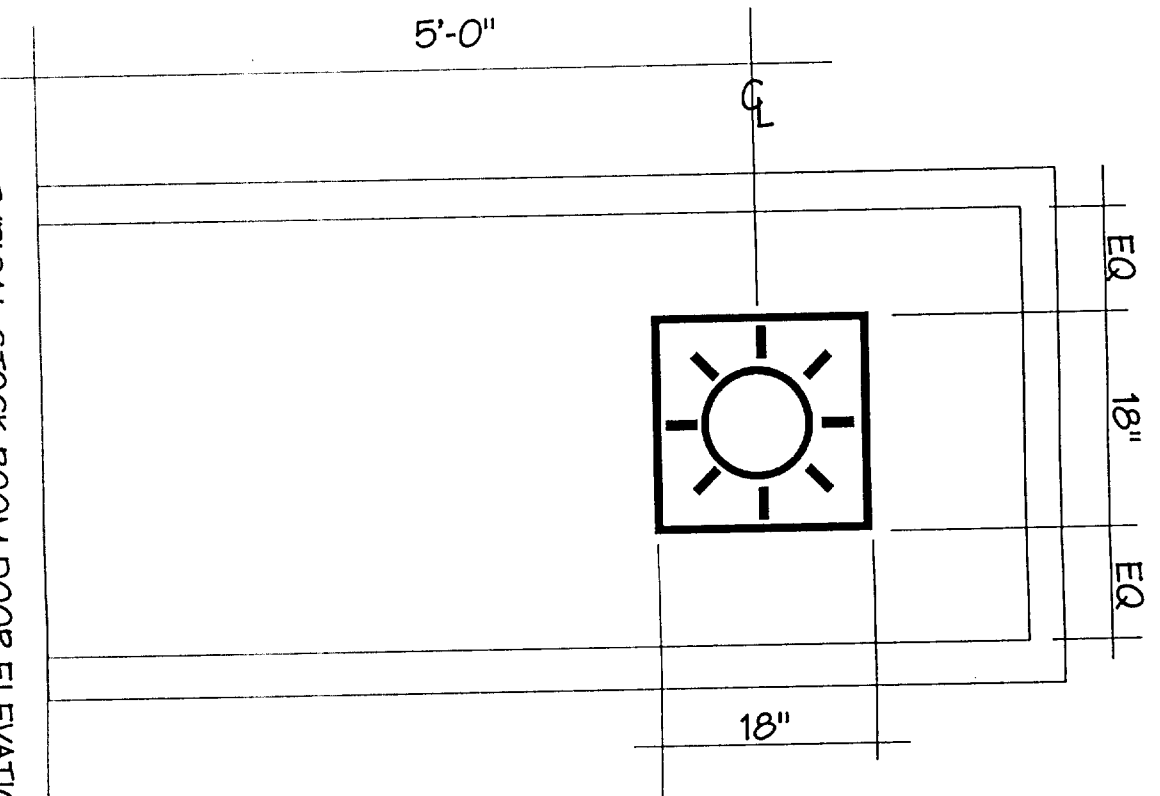

TYPICAL STOCK ROOM DOOR ELEVATION
SCALE: 3/4"=1'-0"

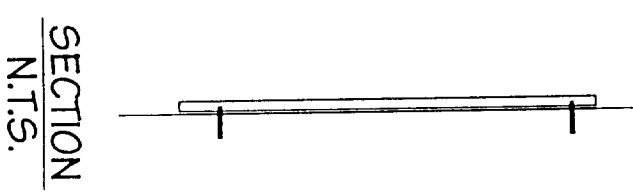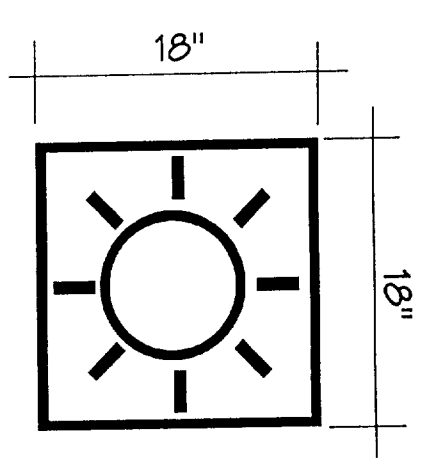

NON-ILLUMINATED DOOR LOGO (QUANTITY: 1)
SCALE: 1" = 1'-0"
3/8" THICK PLATE LOGO--
BORDER & SUNBURST
FINISHED SILVER
PIN MOUNT FLUSH TO DOOR

CLIENT SUNGLASS HUT WATCH STATION	LOCATION SPACE #2003 DOWNTOWN PLAZA SACRAMENTO, CA	DATE 4-28-00	DRAWING NO. 000506	DRAWN BY K. SHAFER	 TRIANGLE SIGN & SERVICE <small>REPRODUCTION IN WHOLE OR PART PROHIBITED WITHOUT EXPRESS PERMISSION OF TRIANGLE SIGN & SERVICE</small>
SALESMAN ROBERT ALTSHULER	SCALE AS NOTED	SHEET NO. 6 OF 6	REVISED	<small>11 AZAR COURT P.O. BOX 24186 BALTIMORE, MARYLAND 21227 (410) 247-5300 FAX (410) 247-1944</small>	