


Sign Permit Application

2101 Arena Blvd. Ste.200 Sacramento CA 95834
 1231 I St. Ste.200 Sacramento CA 95814
 (916) 808-5656
 * Required Information

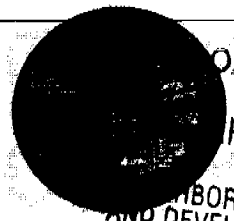

PAID
 OF SACRAMENTO

PR 11 2006

NEIGHBORHOODS PLANNING
 AND DEVELOPMENT SERVICES

Inspection Line

(916) 808-7622 or 808-5716

Sign Permit # 0604942 Area _____

***Sign Address**

431 1st St. 103

APN # <u>002-0010-042</u> Zone:	DR-PB / PUD / SC:	P / ZA File:
---------------------------------	-------------------	--------------

***Sign Applicant**

Pro Ad Signs
 Property Owner \ License Contractor:

Address: 561 W. OAKS Blvd. Ste A Rocklin 95765 Phone: 435.1055

Contractor License # 857405 Class C-45

***Sign Information**


Attached		Detached	
Bldg. Tenant Frontage	<u>40' 3"</u> lineal. foot	Parcel Street Frontage	lineal. foot

Sign I.D. Tag	*Ht. x Wth.	= Sign Area	Sign Copy
<u>S 060195</u>	<u>19" x 91"</u>	<u>12.2</u>	<u>SOUPS in the city</u>
<u>S</u>			
<u>S</u>			
<u>S</u>			

Required Plan Review Approvals | Structural | Electrical | Design Review

Code	Final Sign Inspection	Approved	Date
<u>99</u>	<u>FOOTING</u>		
<u>99</u>	<u>BUILDING</u>		
<u>98</u>	<u>ELECTRICAL</u>		
<u>n/a</u>	<u>SPECIAL INSPECTION</u>		

THIS SIGN PERMIT SHALL EXPIRE BY LIMITATION IF WORK AUTHORIZED IS NOT COMMENCED WITHIN 180 DAYS

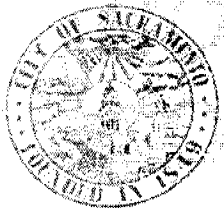

Fees			
Cashier	Description	Date	Amount
	Sign Application Fee		
	Other		
	Balance		
Total	Sign Permit Fee		<u>144.30</u>

x Mark Oll 9/11/06 Approved Sign Permit

CITY COPY

ISOPSI

91"

19"


11 3/4"
6 1/2"

THE APPROVAL OF ALL ELECTRICAL WORK IS SUBJECT TO FIELD INSPECTIONS



CITY OF SACRAMENTO
APR 11 2006
NEIGHBORHOODS PLANNING AND DEVELOPMENT SERVICE



All electrical work must be U.L. labeled or be of equivalent standards, N.E.C. Sec. 90-6/and comply with chapter 14, Div. 2 of The Sacramento City Code.
EQUIPMENT MUST BE USED AS DESIGN INTENDED
SUBJECT TO FIELD INSPECTIONS

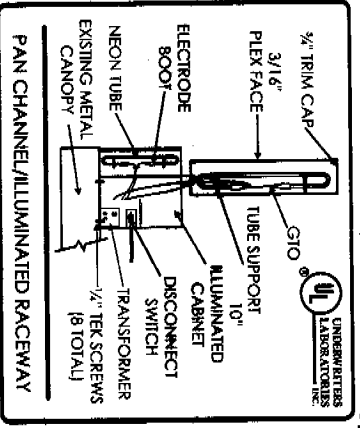

LETTER TYPE: ILLUMINATED PAN CHANNEL
 FACES: 3/16" O15 WHITE W/ VINYL OVERLAY
 TRIM CAP: 3/4" BLACK
 RETURNS: 5" BLACK
 NEON: 15 MM. 6500 WHITE
 STOREFRONT: 40"-3"
 NOTES: LIME GREEN, PLUM PURPLE & MATTE BLACK

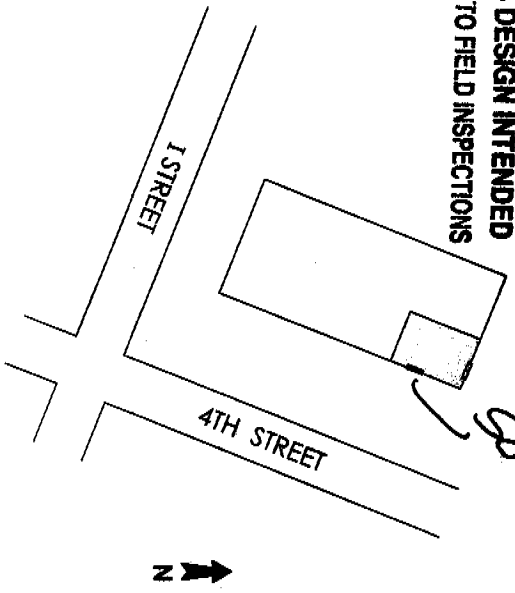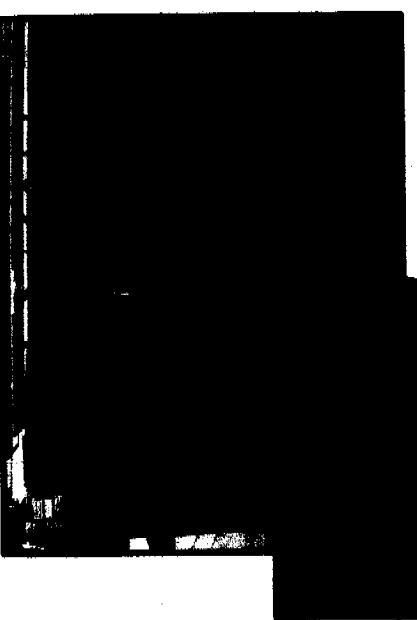

PROAD
 SIGNS & LIGHTING
 Bringing Corporate Identifies to Light™
 Proad Signs & Lighting, Inc.
 5941 York Oaks Boulevard
 Rocklin, CA 95745
 1 916.435.1055
 916.435.2022
 F 916.435.2066
 www.ProadSigns.com
 001#857405

Date: 1/30/06
 Project: SOUP IN THE CITY
 Location: 4311 1ST. SUITE 103
 SACRAMENTO, CA 95813

Acct. Rep: MICHAEL GRATTON
 Permits By: CITY OF SAC
 Revisions: A 1/16/06 B
 C D E

Drawing #: 027A-06SD
 Designer: *Christy Davis*
 File Name: SOUP IN THE CITY
 Sq. Feet: 12 Scale: NTS

APPROVED BY
 Landlord
 CITY COPY
 Tenant

The contents of this document are exclusive property of Proad Signs & Lighting, Inc. Any unauthorized reproduction is subject to a \$1,000 design fee.