

**CITY OF SACRAMENTO**  
1231 I Street, Sacramento, CA 95814

**Permit No: 0102433**  
**Insp Area: 4**

**Site Address: 1721 NORTH BEND DR SAC**  
Parcel No: 225-1110-108

Sub-Type: NOTHR  
Housing (Y/N): N

**CONTRACTOR**  
TENNAR RENAISSANCE INC.  
2240 DOUGLAS BL  
ROSEVILLE CA 95661

**OWNER**  
TENNAR RENAISSANCE  
2240 DOUGLAS BL  
ROSEVILLE CA 95661

**ARCHITECT**

**Nature of Work: NEW PATIO COVER 192 SF**

**CONSTRUCTION LENDING AGENCY:** I hereby affirm under penalty of perjury that there is a construction lending agency for the performance of the work for which this permit is issued (Sec. 3097, Civ. C.).

Lender's Name \_\_\_\_\_ Lender's Address \_\_\_\_\_

**LICENSED CONTRACTORS DECLARATION:** I hereby affirm under penalty of perjury that I am licensed under provisions of Chapter 9 (commencing with section 7000) of Division 3 of the Business and Professions Code and my license is in full force and effect.

License Class \_\_\_\_\_ License Number \_\_\_\_\_ Date \_\_\_\_\_ Contractor Signature \_\_\_\_\_

**OWNER-BUILDER DECLARATION:** I hereby affirm under penalty of perjury that I am exempt from the contractors License Law for the following reason (Sec. 7031.5, Business and Professions Code, any city or county which requires a permit to construct, alter, improve, demolish, or repair any structure, prior to its issuance, also requires the applicant for such permit to file a signed statement that he or she is licensed pursuant to the provisions of the Contractors License Law (Chapter 9 (commencing with Section 7000) of Division 8 of the Business and Professions Code) or that he or she is exempt therefrom and the basis for the alleged exemption. Any violation of Section 7031.5 by any applicant for a permit subjects the applicant to a civil penalty of not more than five hundred dollars (\$500.00).

I, as a owner of the property, or my employees with wages as their sole compensation, will do the work, and the structure is not intended or offered for sale (Sec. 7044, Business and Professional Code. The Contractors License Law does not apply to an owner of property who builds or improves thereon, and who does such work himself or herself or through his/her own employees, provided that such improvements are not intended or offered for sale. If, however, the building or improvement is sold within one year of completion, the owner-builder will have the burden of proving that he/she did not build or improve for the purpose of sale.)


I, as owner of the property, am exclusively contracting with licensed contractors to construct the project (Sec. 7044, Business and Professions Code. The Contractors License Law does not apply to an owner of property who builds or improves thereon, and who contracts for such projects with a contractor(s) licensed pursuant to the Contractors License Law).

I am exempt under Sec. \_\_\_\_\_ B & PC for this reason: \_\_\_\_\_

Date 4/9/01 \_\_\_\_\_ Owner Signature 

**IN ISSUING THIS BUILDING PERMIT,** the applicant represents, and the city relies on the representation of the applicant, that the applicant verified all measurements and locations shown on the application or accompanying drawings and that the improvement to be constructed does not violate any law or private agreement relating to permissible or prohibited locations for such improvements. This building permit does not authorize any illegal location of any improvement or the violation of any private agreement relating to location of improvements.

I certify that I have read this application and state that all information is correct. I agree to comply with all city and county ordinances and state laws relating to building construction and hereby authorize representative(s) of this city to enter upon the above mentioned property for inspection purposes.

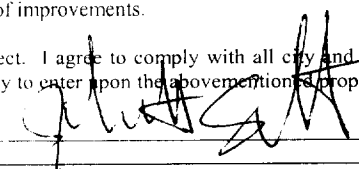Date 4/9/01 \_\_\_\_\_ Applicant Agent Signature 

**WORKER'S COMPENSATION DECLARATION:** I hereby affirm under penalty of perjury one of the following declarations:

I have and will maintain a certificate of consent to self-insure for workers' compensation as provided for by Section 3700 of the Labor Code, for the performance of work for which the permit is issued.

I have and will maintain workers' compensation insurance, as required by Section 3700 of the Labor Code, for the performance of the work for which this permit is issued. My workers' compensation insurance carrier and policy number are:

Carrier TRANSCONTINENTAL INSURANCE CO Policy Number WC166792277 Exp Date 06/01/2001

(This section need not be completed if the permit is for \$100 or less) I certify that in the performance of the work for which this permit is issued, I shall not employ any person in any manner so as to become subject to the workers' compensation laws of California and agree that if I should become subject to the workers' compensation provisions of Section 3700 of the Labor Code, I shall forthwith comply with those provisions.

Date 4/9/01 \_\_\_\_\_ Applicant Signature 

**WARNING: FAILURE TO SECURE WORKER'S COMPENSATION COVERAGE IS UNLAWFUL AND SHALL SUBJECT AN EMPLOYER TO CRIMINAL PENALTIES AND CIVIL FINES UP TO ONE HUNDRED THOUSAND DOLLARS (\$100,000) IN ADDITION TO THE COST OF COMPENSATION, DAMAGES AS PROVIDED FOR IN SECTION 3706 OF THE LABOR CODE, INTEREST AND ATTORNEY'S FEE.**

**THIS PERMIT SHALL EXPIRE BY LIMITATION IF WORK IS NOT COMMENCED WITHIN 180 DAYS.**

Date of Request: \_\_\_\_\_

By: \_\_\_\_\_

**CITY OF SACRAMENTO DEVELOPMENT SERVICES DIVISION  
PLANNING AND ZONING INFORMATION REQUEST**

Project Address: 1721 NORTH BEND DR

Assessor's Parcel Number: 225.1110.106 / 225.1110.108

Previous Use: SFR

Description of Request/Proposed Use: ADD PATIO COVER

Is This a Change of Use? NO

Prior Applications for Project Site(P#, Z#, DRPB#): 1R99-126 Zoning Designation: R1-PUD

Comments: POSTS MUST BE AT LEAST 4' FROM HOUSE, IF STRUCTURE IS GREATER THAN 60' FROM FRONT PROPERTY LINE NO REAR OR INT SIDE YARD SETBACK REQ'D

Are There Any Planning Issues?: (circle one) YES  NO

- \* Staff Site Plan Check Required? (Circle one) YES  NO
- \* Field Inspection Required? (Circle one) YES  NO
- \* Design Review/Preservation Required?: (Circle one) YES  NO

Planning Review by/Date: [Signature] 2/26/01

A list of items that must be reviewed by Planning is provided on the reverse side of this form.

MICROFILM AFTER FINAL


0102433

09/19/2000 16:50

9289396


SOMERSET

PAGE 04

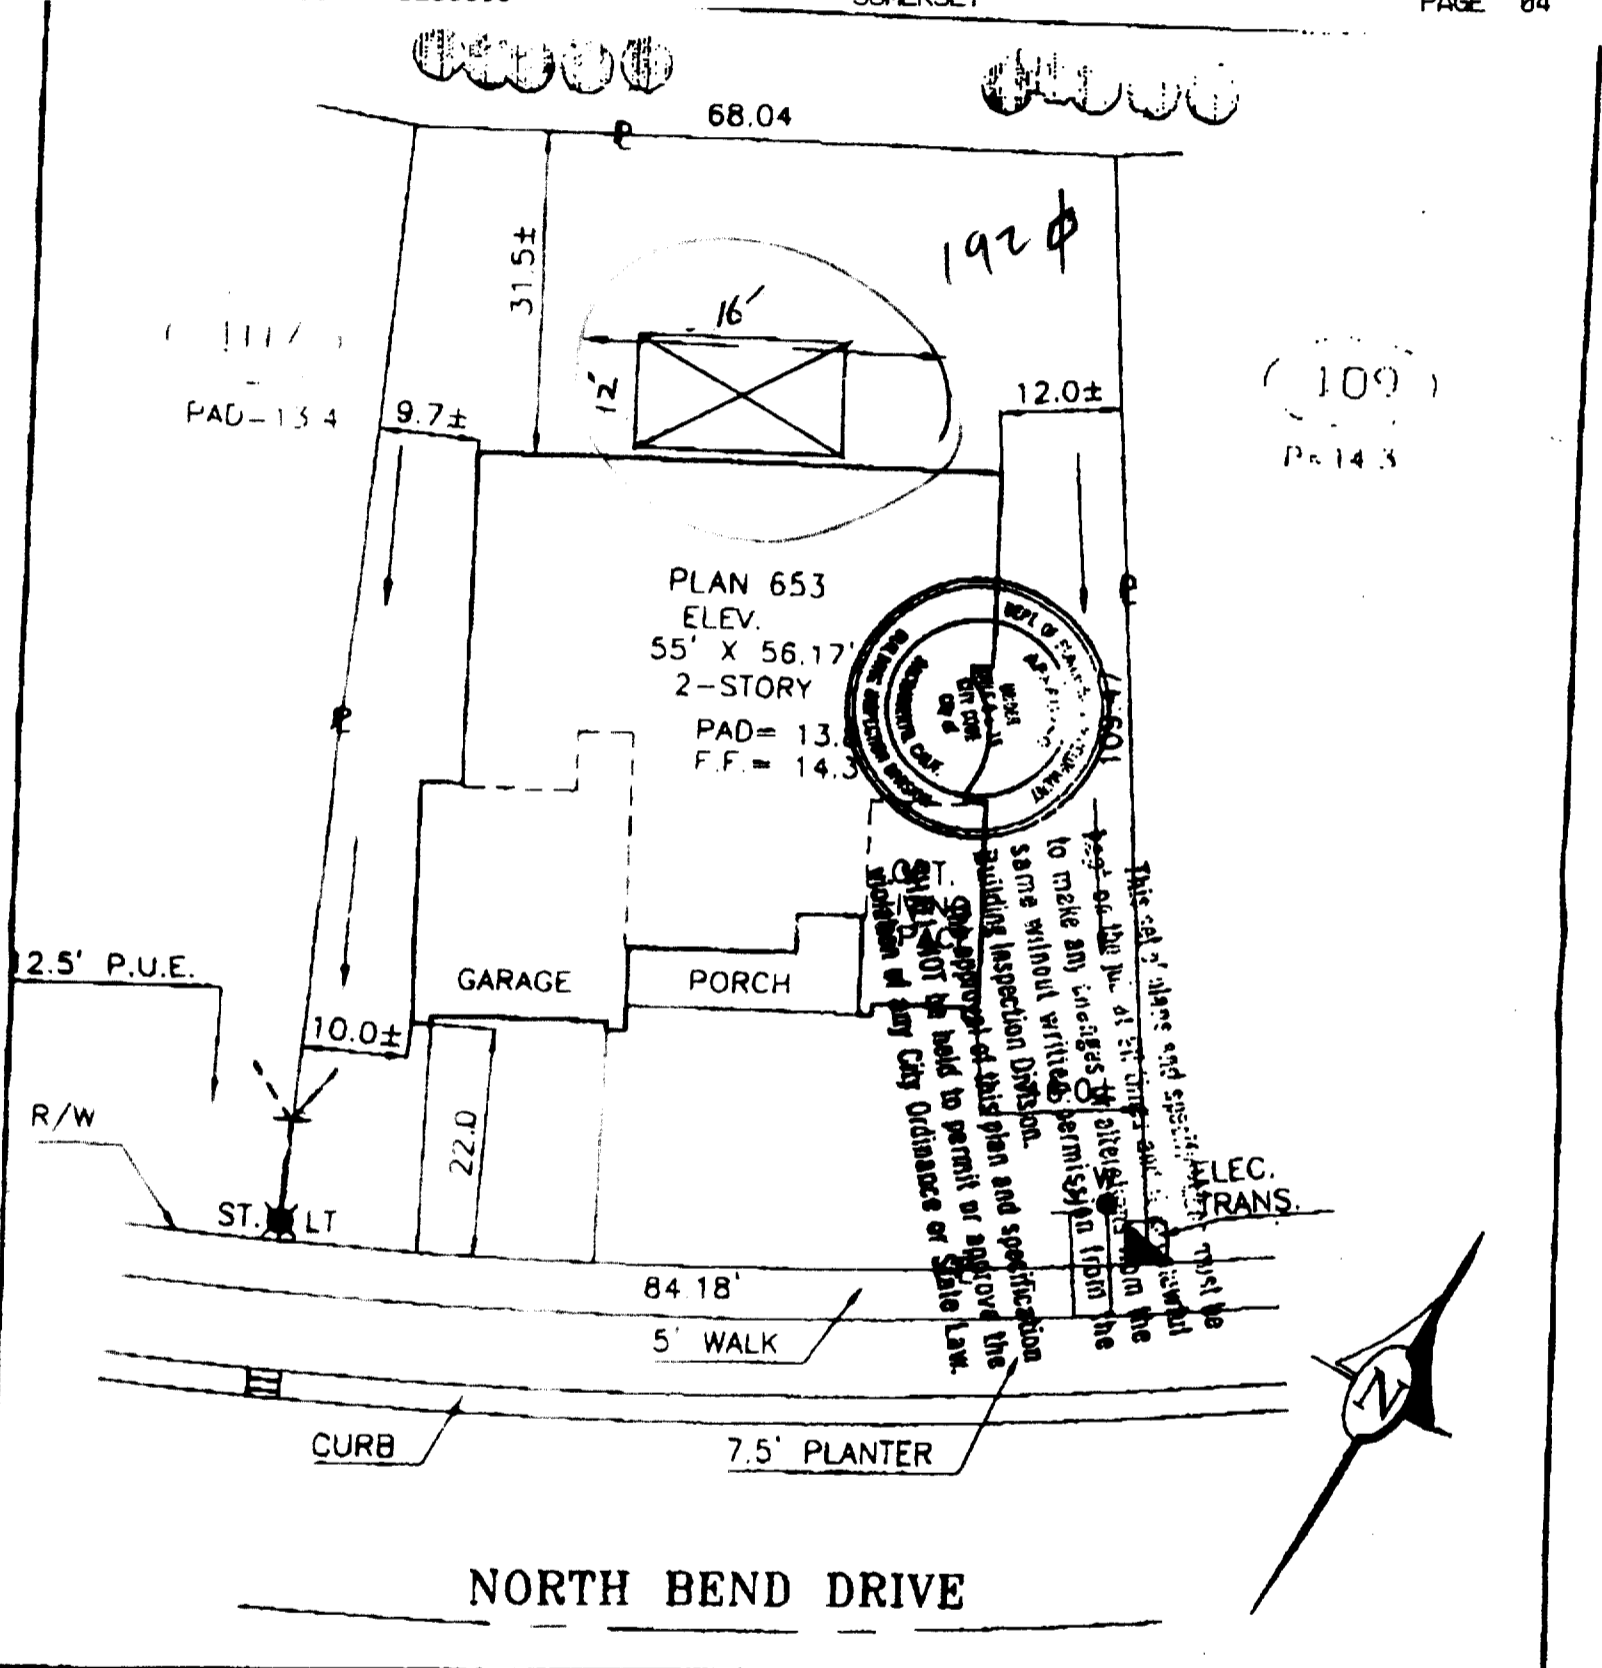

DIMENSIONS SHOWN ARE APPROXIMATE EXCEPT FOR MINIMUMS REQUIRED BY ORDINANCE. THIS PLOT DOES NOT REFLECT AS BUILT CONDITIONS AND MAY VARY FROM THIS PLAN.



<b>RENAISSANCE</b>		NORTHPOINTE PARK VILLAGE 12		PLOT PLAN NOTES:
2240 DOUGLAS BLVD. SUITE 200, ROSEVILLE, CALIFORNIA 95661 PHONE (916) 778-0883 FAX (916) 778-4088		NORTHPOINTE PARK UNIT 12 CITY OF SACRAMENTO SACTO. COUNTY CALIFORNIA		
ADDRESS: 1721 NORTH BEND DRIVE	LOT SQ. FT.: 8,382.6	LOT COV: 32.1%	APN:	LOT 108
PLAN NO.: 653	APPROVED BY:	REAR YARD COVERAGE: %	DATE of plans and specifications must be kept on the job at all times and it is unlawful to make any changes or alterations from the same without written permission from the Building Inspection Division.	
DRAWN BY: R.P.	APPROVED BY:	SCALE: 1"=20'	The approval of this plan and specification SHALL NOT be held to permit or approve the violation of any City Ordinance or State Law.	

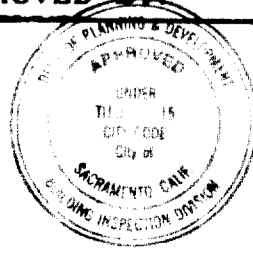

kept on the job at all times and it is unlawful to make any changes or alterations from the same without written permission from the Building Inspection Division.

The approval of this plan and specification SHALL NOT be held to permit or approve the violation of any City Ordinance or State Law.

*[Handwritten signature]*  
2/26/01

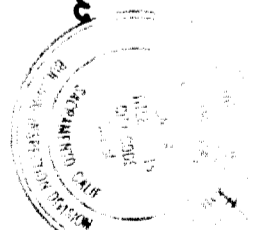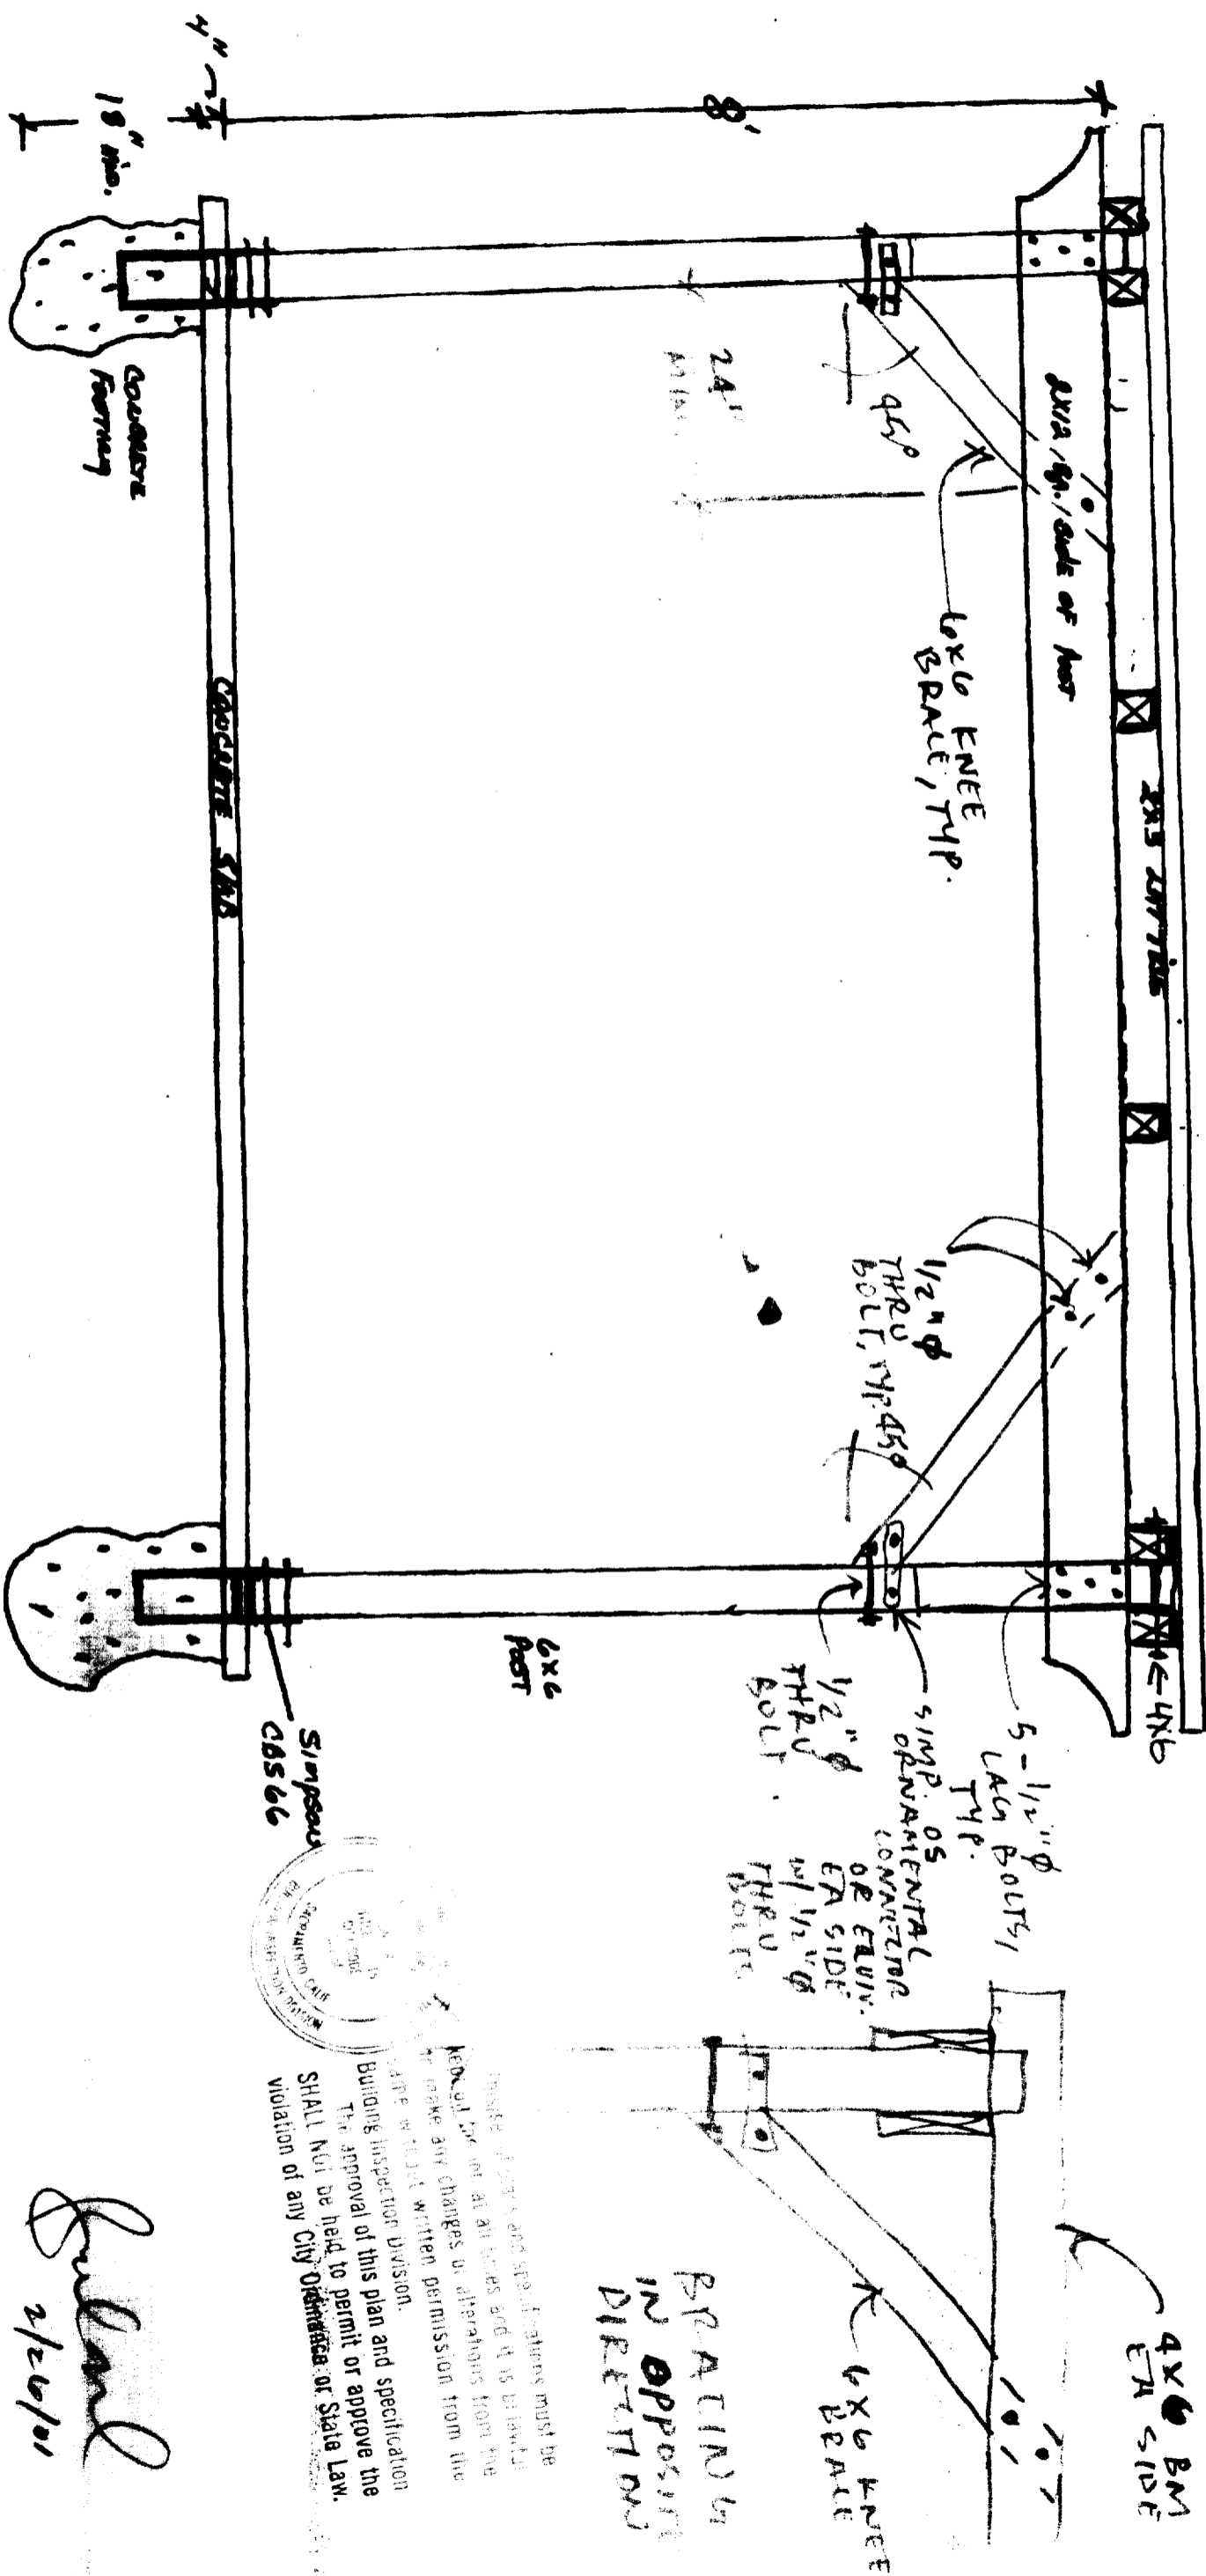


These reports and specifications must be made in ink at all times and it is unlawful to make any changes or alterations from the same without written permission from the Building Inspection Division.  
 The approval of this plan and specification SHALL NOT be held to permit or approve the violation of any City Ordinance or State Law.

PRACTICE IN OPPOSITE DIRECTION

BT 108


*Endall*  
2/20/01

0102433

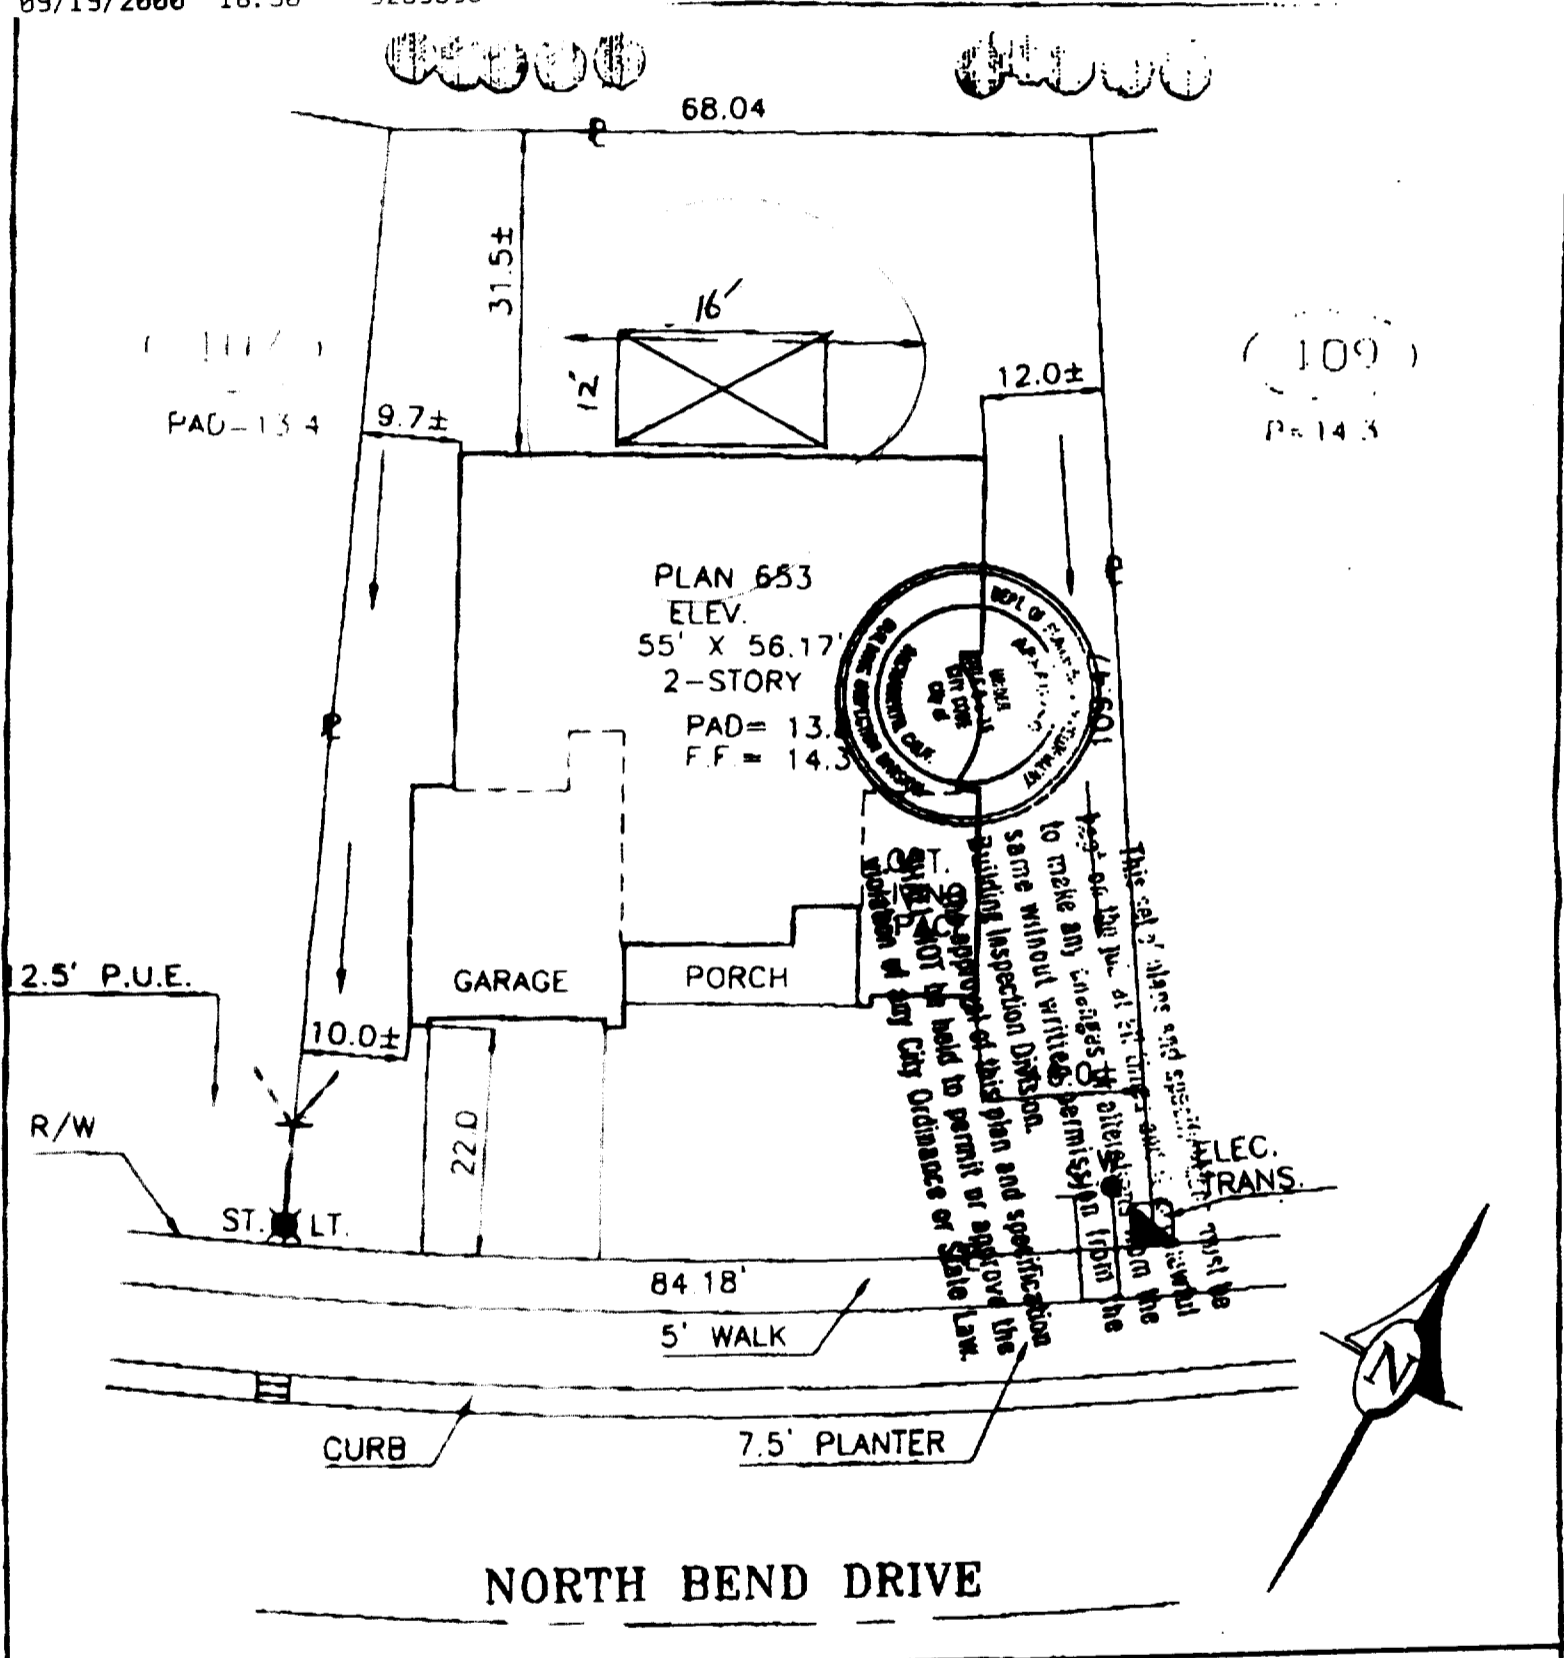


DIMENSIONS SHOWN ARE APPROXIMATE EXCEPT FOR MINIMUMS REQUIRED BY ORDINANCE. THIS PLOT DOES NOT REFLECT AS BUILT CONDITIONS AND MAY VARY FROM THIS PLAN.

<b>RENAISSANCE</b> 2240 DOUGLAS BLVD. SUITE 250, ROSEVILLE, CALIFORNIA 95661 PHONE (916) 778-4083 FAX (916) 778-4088	NORTHPOINTE PARK VILLAGE 12		PLOT PLAN NOTES:
	NORTHPOINTE PARK UNIT 12 CITY OF SACRAMENTO SACTO. COUNTY CALIFORNIA		
ADDRESS: 1721 NORTH BEND DRIVE	LOT COV: 32.1%	APN:	LOT 108
PLAN NO.: 653	LOT SQ. FT.: 8,382.6	REAR YARD COVERAGE: %	
DRAWN BY: R.P.	APPROVED BY:	DATE: SCALE: 1"=20'	

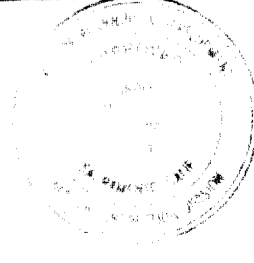

This set of plans and specifications must be kept on the job at all times and it is unlawful to make any changes or alterations from the same without written permission from the Building Inspection Division.  
 The approval of this plan and specification SHALL NOT be held to permit or approve the violation of any City Ordinance or State Law.

*Handwritten signature and date: 2/24/01*

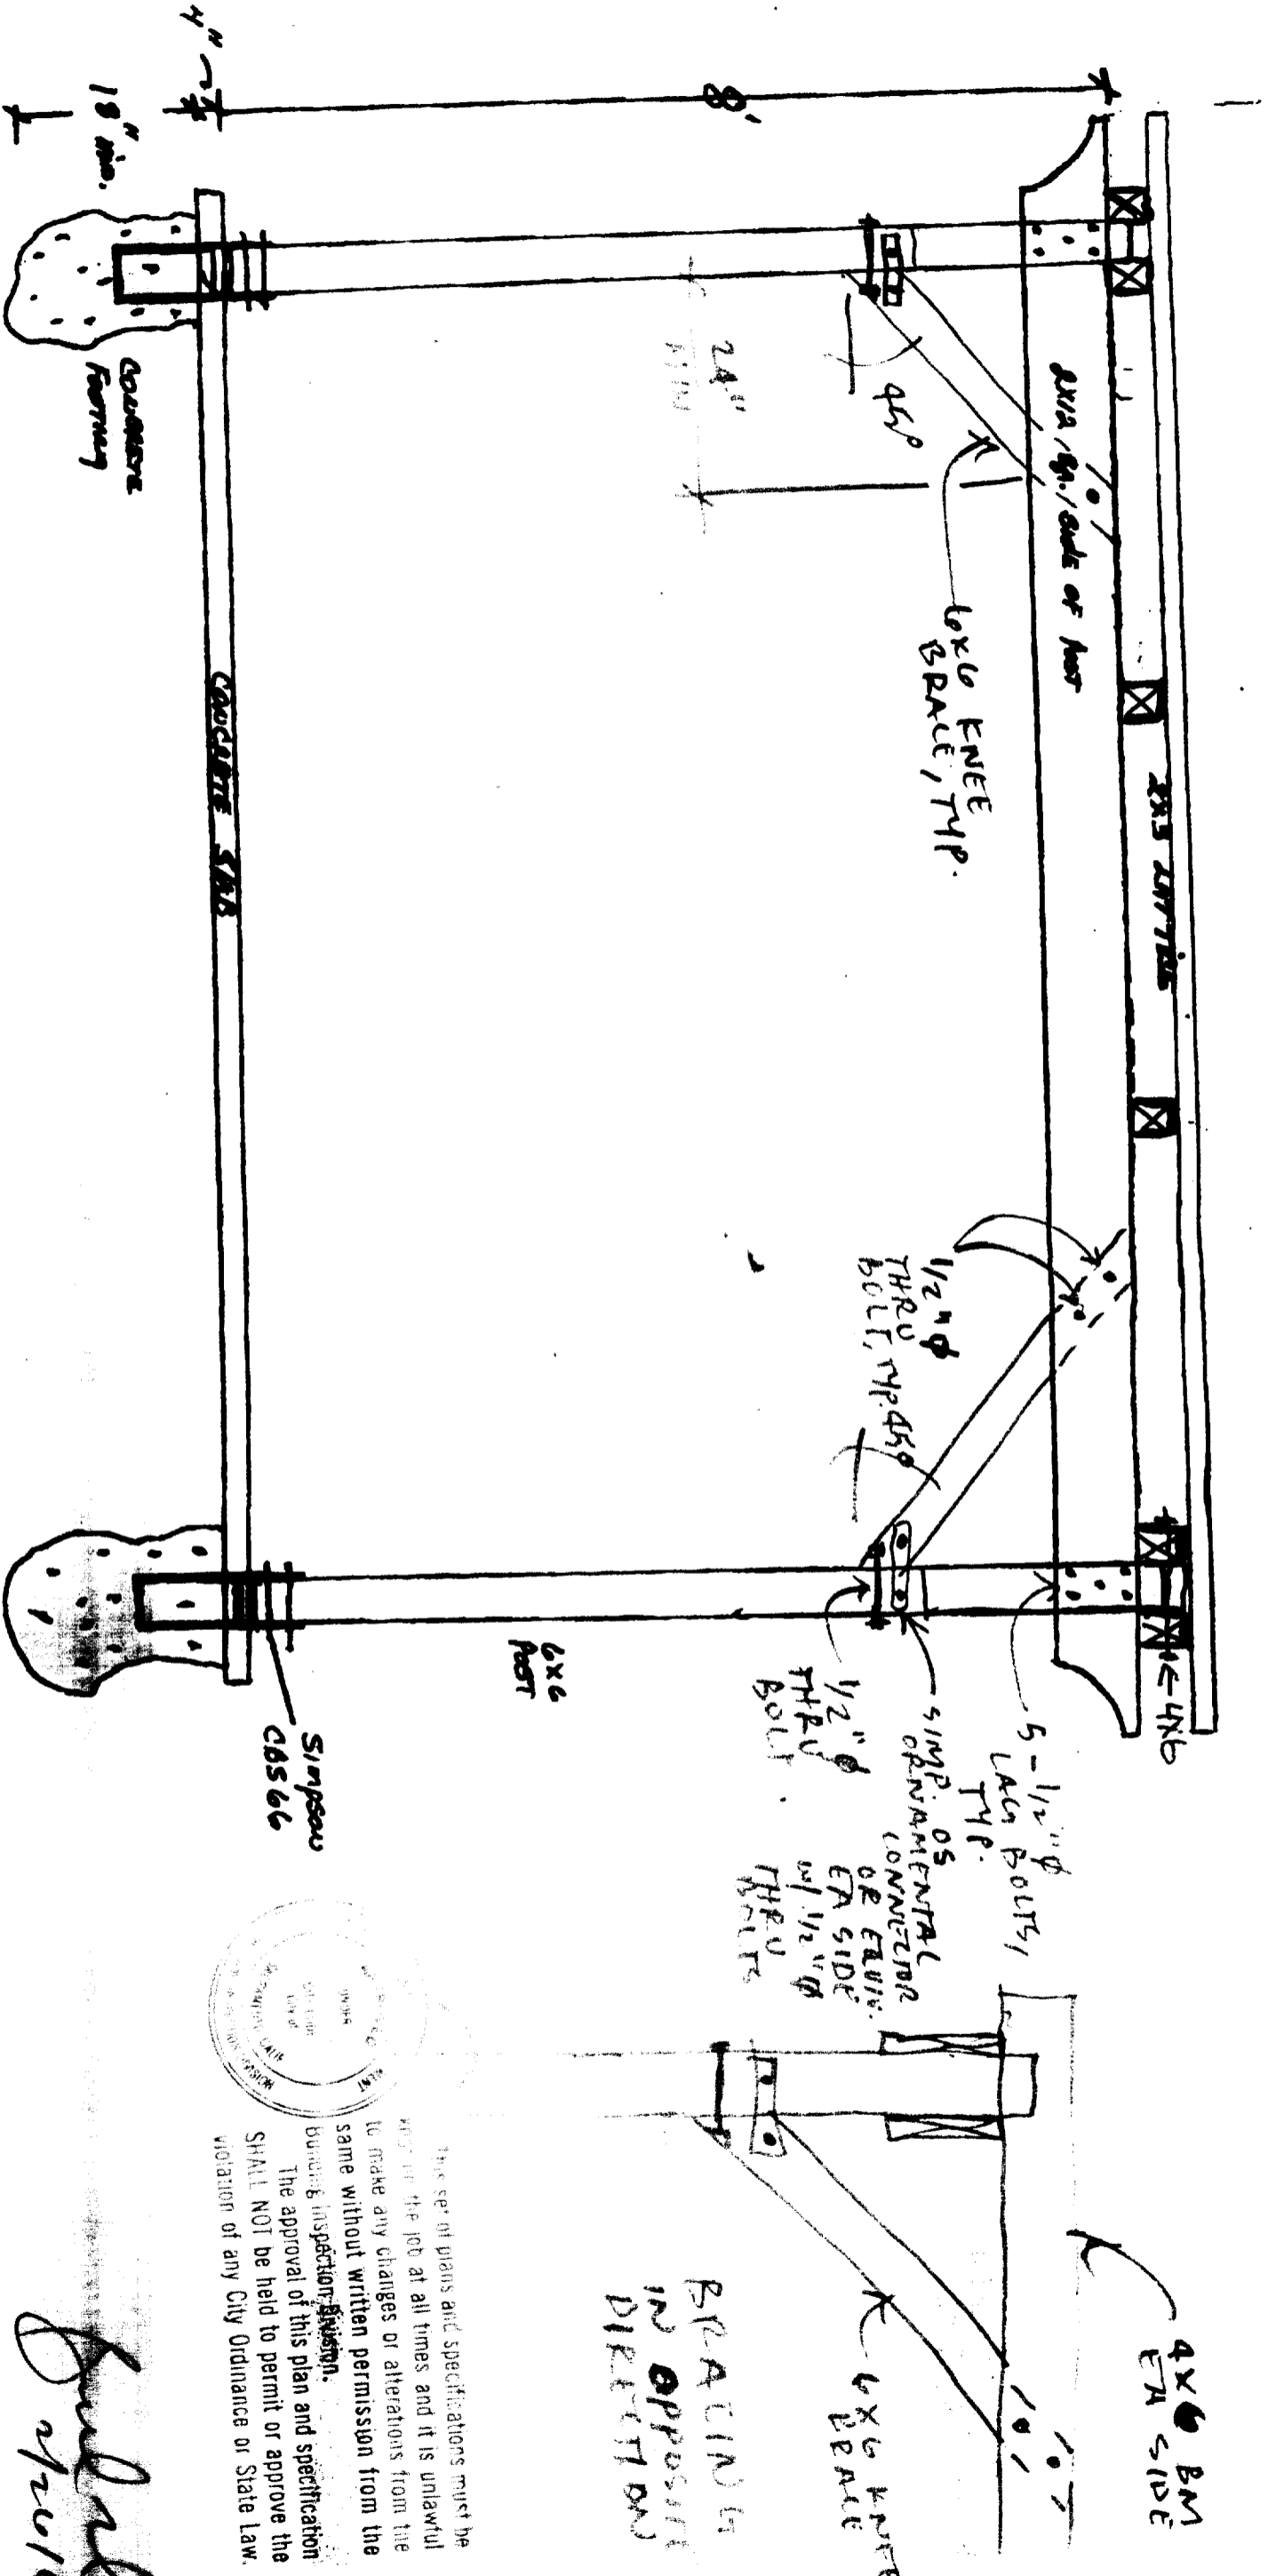

These set of plans and specifications must be approved by the City of Los Angeles, Department of Public Works, Division of Building Inspection, at all times and it is unlawful to make any changes or alterations from the same without written permission from the Building Inspector. The approval of this plan and specification SHALL NOT be held to permit or approve the violation of any City Ordinance or State Law.

*Handwritten signature:* [Signature]

BT 108