

**CITY OF SACRAMENTO**

**1231 I Street, Sacramento, CA 95814**

**Permit No: 9805818**

**Insp Area: 1**

**Site Address: 1911 I ST SAC**

**Parcel No: 0070013012**

**Sub-Type: NOTHR**

**Housing (Y/N): N**

CONTRACTOR

MARK BAKER  
216 32ND ST  
SAC CA 95816

OWNER

WHISLER MARK  
2509 CAPITOL AV  
SACRAMENTO CA 95816

ARCHITECT

**Nature of Work: TERMITE/DRYROT REPAIR TO PORCH AND STAIRS**

**CONSTRUCTION LENDING AGENCY :** I hereby affirm under penalty of perjury that there is a construction lending agency for the performance of the work for which this permit is issued (Sec. 3097, Civ. C).

Lender's Name \_\_\_\_\_ Lender's Address \_\_\_\_\_

**LICENSED CONTRACTORS DECLARATION:** I hereby affirm under penalty of perjury that I am licensed under provisions of Chapter 9 (commencing with section 7000) of Division 3 of the Business and Professions Code and my license is in full force and effect.

License Class B License Number 607462 Date 7-3-98 Contractor Signature Mark Baker

**OWNER-BUILDER DECLARATION:** I hereby affirm under penalty of perjury that I am exempt from the contractors License Law for the following reason (Sec. 7031.5, Business and Professions Code; any city or county which requires a permit to construct, alter, improve, demolish, or repair any structure, prior to its issuance, also requires the applicant for such permit to file a signed statement that he or she is licensed pursuant to the provisions of the Contractors License Law (Chapter 9 (commencing with Section 7000) of Division 8 of the Business and Professions Code) or that he or she is exempt therefrom and the basis for the alleged exemption. Any violation of Section 7031.5 by any applicant for a permit subjects the applicant to a civil penalty of not more than five hundred dollars (\$500.00);

I, as a owner of the property, or my employees with wages as their sole compensation, will do the work, and the structure is not intended or offered for sale (Sec. 7044, Business and Professional Code: The Contractors License Law does not apply to an owner of property who builds or improves thereon, and who does such work himself or herself or through his/her own employees, provided that such improvements are not intended or offered for sale. If, however, the building or improvement is sold within one year of completion, the owner-builder will have the burden of proving that he/she did not build or improve for the purpose of sale.)

I, as owner of the property, am exclusively contracting with licensed contractors to construct the project (Sec. 7044, Business and Professions Code: The Contractors License Law does not apply to an owner of property who builds or improves thereon, and who contracts for such projects with a contractor(s) licensed pursuant to the Contractors License Law).

I am exempt under Sec. \_\_\_\_\_ B & PC for this reason: \_\_\_\_\_

Date \_\_\_\_\_ Owner Signature \_\_\_\_\_

**IN ISSUING THIS BUILDING PERMIT,** the applicant represents, and the city relies on the representation of the applicant, that the applicant verified all measurements and locations shown on the application or accompanying drawings and that the improvement to be constructed does not violate any law or private agreement relating to permissible or prohibited locations for such improvements. This building permit does not authorize any illegal location of any improvement or the violation of any private agreement relating to location of improvements.

I certify that I have read this application and state that all information is correct. I agree to comply with all city and county ordinances and state laws relating to building construction and hereby authorize representative(s) of this city to enter upon the abovementioned property for inspection purposes.

Date 7-3-98 Applicant/Agent Signature Mark Baker

**WORKER'S COMPENSATION DECLARATION:** I hereby affirm under penalty of perjury one of the following declarations:  
I have and will maintain a certificate of consent to self-insure for workers' compensation as provided for by Section 3700 of the Labor Code, for the performance of work for which the permit is issued.

I have and will maintain workers' compensation insurance, as required by Section 3700 of the Labor Code, for the performance of the work for which this permit is issued. My workers' compensation insurance carrier and policy number are:

Carrier \_\_\_\_\_ Policy Number \_\_\_\_\_

(This section need not be completed if the permit is for \$100 or less) I certify that in the performance of the work for which this permit is issued, I shall not employ any person in any manner so as to become subject to the workers' compensation laws of California and agree that if I should become subject to the workers' compensation provisions of Section 3700 of the Labor Code, I shall forthwith comply with those provisions.

Date 7-3-98 Applicant Signature Mark Baker

**WARNING: FAILURE TO SECURE WORKER'S COMPENSATION COVERAGE IS UNLAWFUL AND SHALL SUBJECT AN EMPLOYER TO CRIMINAL PENALTIES AND CIVIL FINES UP TO ONE HUNDRED THOUSAND DOLLARS (\$100,000) IN ADDITION TO THE COST OF COMPENSATION, DAMAGES AS PROVIDED FOR IN SECTION 3706 OF THE LABOR CODE, INTEREST AND ATTORNEY'S FEE.**

**THIS PERMIT SHALL EXPIRE BY LIMITATION IF WORK IS NOT COMMENCED WITHIN 180 DAYS.**

CITY OF SACRAMENTO  
DEVELOPMENT SERVICES DIVISION

# EXPRESS PLAN REVIEW

SUBMITTAL DATES					
First Review		2nd Review		3rd Review	
IN	OUT	IN	OUT	IN	OUT
6/25/98	/ /	/ /	/ /	/ /	/ /

PLAN CHECK # 9805818R  
 ADDRESS: 1911 I ST  
 Commercial  Residential

ACCEPTED by (Staff):  
*Bill M.*

DISCIPLINE	1ST REVIEW			2ND REVIEW			3RD REVIEW		
	Status	Staff	Date	Status	Staff	Date	Status	Staff	Date
LIFE SAFETY	13	BTL	7/1						
STRUCTURAL	13	GTL	7/1						
MECHANICAL/PLUMBING									
ELECTRICAL									
FIRE									
PLANNING									

STAFF COMMENTS: \_\_\_\_\_  
 \_\_\_\_\_  
 \_\_\_\_\_  
9805818R

(E) upstairs posts & railings are not being replaced railings are w/ 29-32" high w/ up to 9" spacing


Replace Rotten stairs matching existing

PRINT ENTIRE STAIR STRUCTURE

CITY OF SACRAMENTO DESIGN REVIEW

PROJECT NO: 98-081  
APPROVED BY: [Signature]  
APPROVAL DATE: 6/25/98

Drawn by: Mark Baker

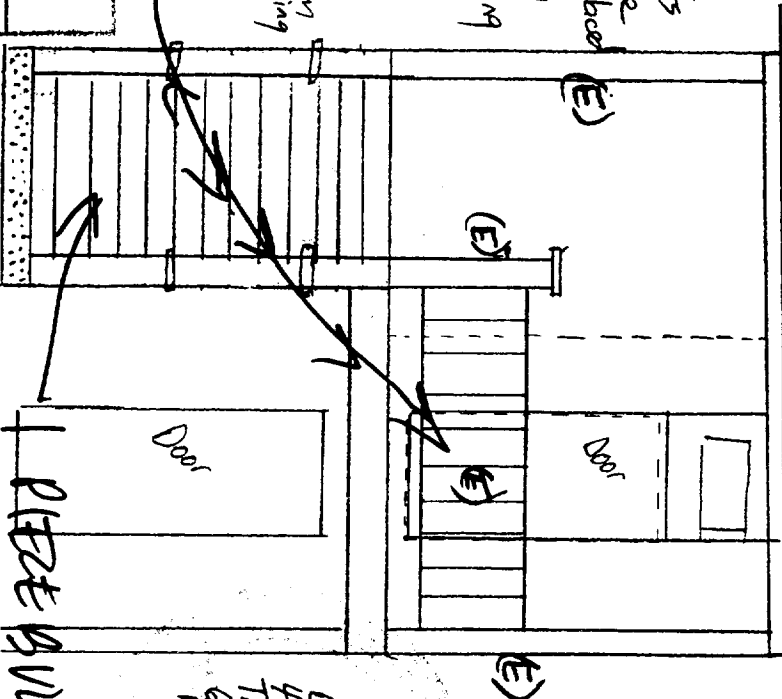

Top of Handrail shall be not less than 34" or more than 38" above treads and ~~landings~~

(E) Replace rotten deck to match Existing

(N) Down stairs 4x4 Posts Trimmed out to 6" to match Existing

PIECE GUNNED TREAD & CLOSED RISERS

Front View 1/4" = 1' JUL 03 1998

1911 I Street Sacramento CA

RECEIVED JUN 25 1998

Building Inspection Division

ISSUED

NOTE: ANY CHANGES MUST BE APPROVED BY DESIGN REVIEW STAFF PRIOR TO CONSTRUCTION

