



0605530

This set of plans and specifications must be kept on the job at all times and it is unlawful to make any changes or alterations from the same without written permission from the City of Sacramento Sign Section.

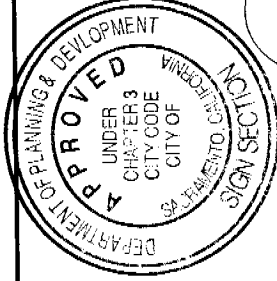


STOREFRONT ANGLES HERE SHOWN STRAIGHT ON

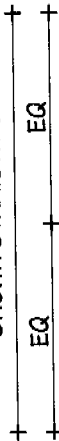


All electrical work must be U.L. labeled or be of equivalent standards, N.E.C. Sec. 90 and comply with chapter 14, Div. 2 of the Sacramento City Code.

SIGN INTENDED
FIELD INSPECTIONS
8'-0" A.F.F.

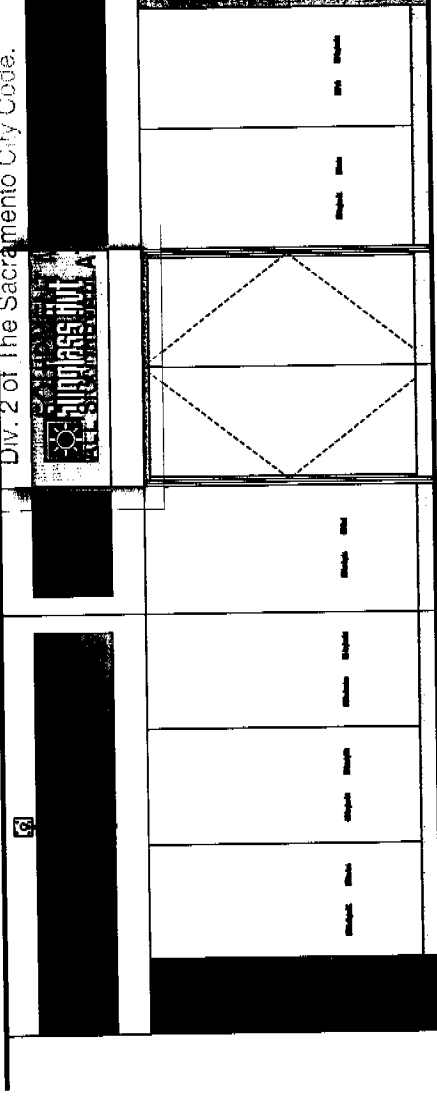

SCALE: 1/4"=1'-0"

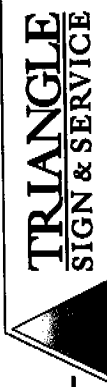

CLIENT & LOCATION



SUNGLASS HUT
DOWNTOWN PLAZA II
545 DOWNTOWN PLAZA
SACRAMENTO, CA 95814

DRAWING NO.

060416 R3

DATE

1/07/06

DRAWN BY

LPR

REVIEWED BY



SEG. NO.

REVISION

R1 4/7/06 LR REVISE BRAX
R3 4/7/06 LR REVISE BRAX LOCATION

11 AZAR COURT / P.O. BOX 24186 BALTIMORE, MARYLAND 21227 - (410) 247-5300 - FAX (410) 247-1944 REPRODUCTION IN WHOLE OR PART PROHIBITED WITHOUT EXPRESS PERMISSION OF TRIANGLE S & S

CITY COPY

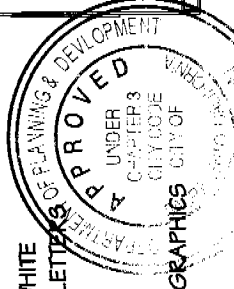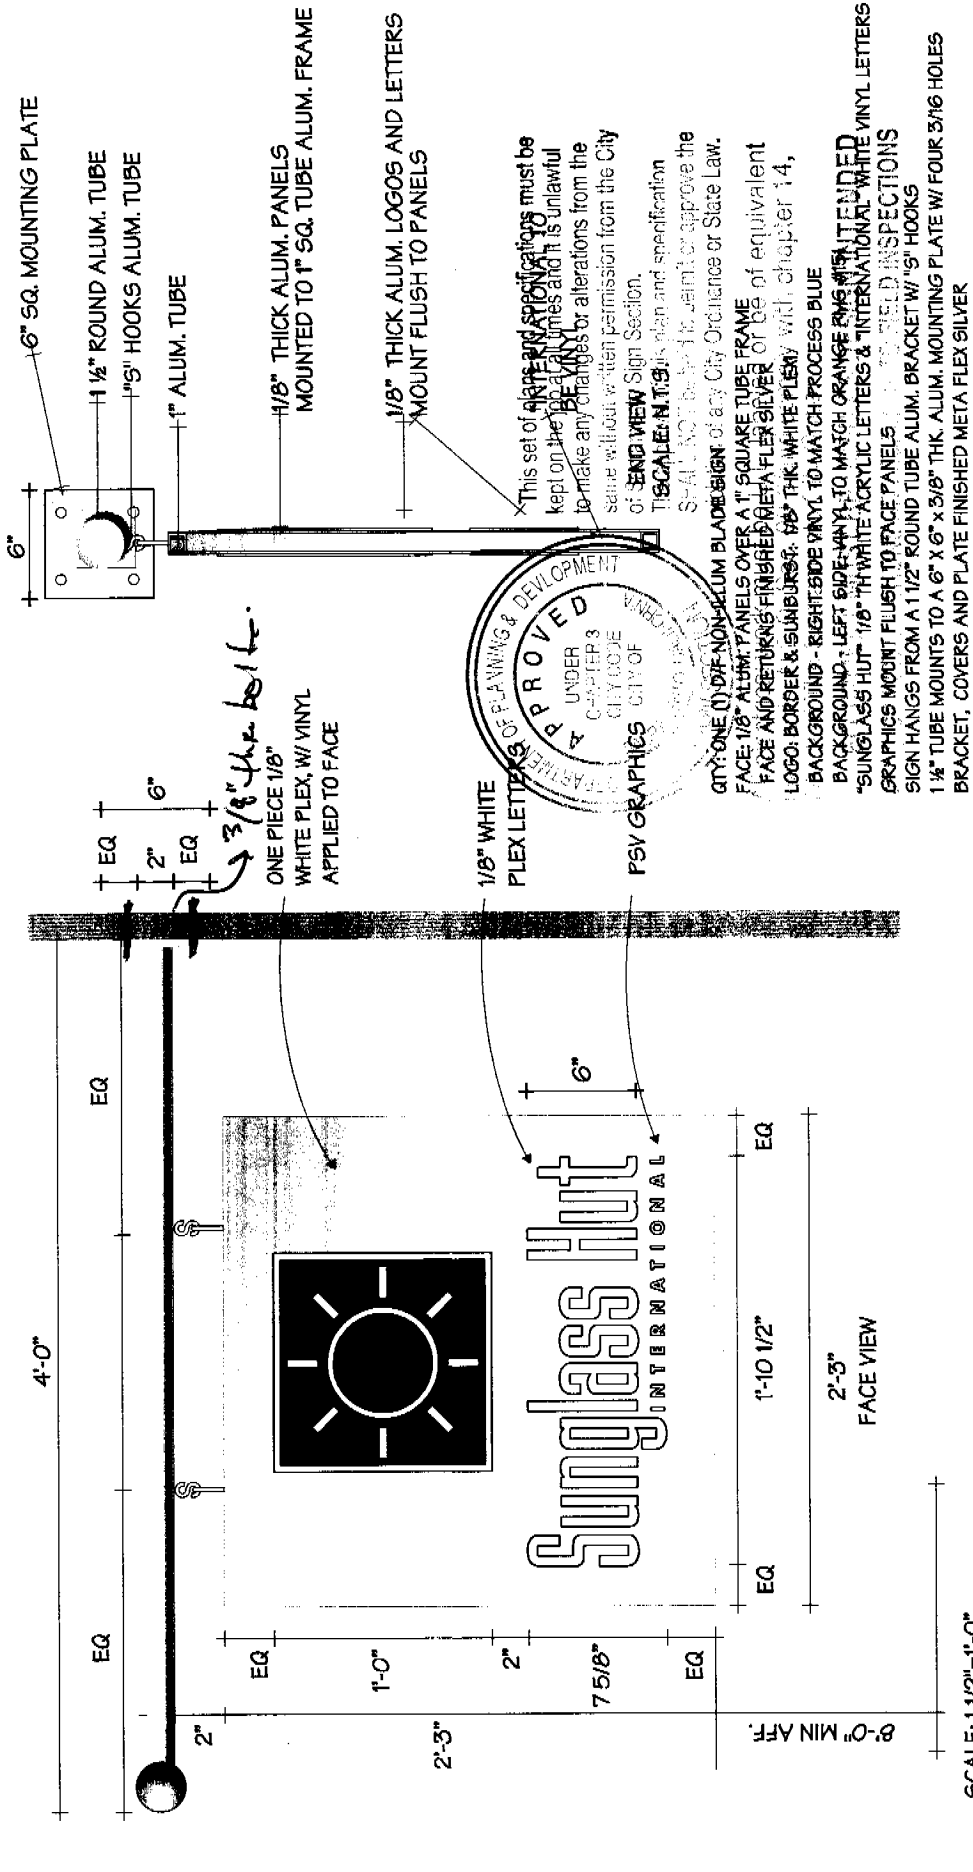

This set of plans and specifications must be kept on the job at all times and it is unlawful to make any changes or alterations from the same without written permission from the City of Sacramento Sign Section.

THIS CONTRACTOR SHALL BE RESPONSIBLE FOR OBTAINING THE NECESSARY PERMITS AND APPROVALS FROM THE CITY OF SACRAMENTO SIGN SECTION.

QTY: ONE (1) DIFFERENTIAL ALUM BLADE SIGN OF ANY CITY OR COUNCIL OR STATE LAW.

FACE: 1/8" ALUM. PANELS OVER A 1" SQUARE TUBE FRAME

FACE AND RETURNING FINISHED FLEX SILVER OR BE OF EQUIVALENT

LOGO: BORDER & SUNBURST: 1/8" THK. WHITE PLEX; WITH CHAPTER 14, BACKGROUND - RIGHT SIDE VINYL TO MATCH PROCESS BLUE

BACKGROUND - LEFT SIDE VINYL TO MATCH ORANGE PMS WITH UNINTENDED

"SUNGLASS HUT" 1/8" THK. WHITE ACRYLIC LETTERS & INTERNATIONAL VINYL LETTERS

GRAPHICS MOUNT FLUSH TO FACE PANELS


SIGN HANGS FROM A 1 1/2" ROUND TUBE ALUM. BRACKET W/ 1" HOOKS

1 1/2" TUBE MOUNTS TO A 6" X 6" X 3/8" THK. ALUM. MOUNTING PLATE W/ FOUR 3/16 HOLES

BRACKET, COVERS AND PLATE FINISHED META FLEX SILVER

TRIANGLE SIGN & SERVICE 11 AZAR COURT / P.O. BOX 24186 BALTIMORE, MARYLAND 21227 - (410) 247-5300 - FAX (410) 247-1944 REPRODUCTION IN WHOLE OR PART PROHIBITED WITHOUT EXPRESS PERMISSION OF TRIANGLE S & S	CLIENT & LOCATION Sunglass Hut SUNGLASS HUT DOWNTOWN PLAZA II 545 DOWNTOWN PLAZA SACRAMENTO, CA 95814	DRAWING NO. 060416 R3	DATE 1/07/06	DRAWN BY LPR	REVIEWED BY _____	REVISION R1 4/7/06 LK REVISE BRAX R2 4/17/06 LK REVISE BRAX LOCATION
	SALESMAN R. ALTSHULER	SHEET NO. 1 OF 2	SCALE AS NOTED	SEG. NO. _____	_____	_____

SCALE: 1 1/2"=1'-0"

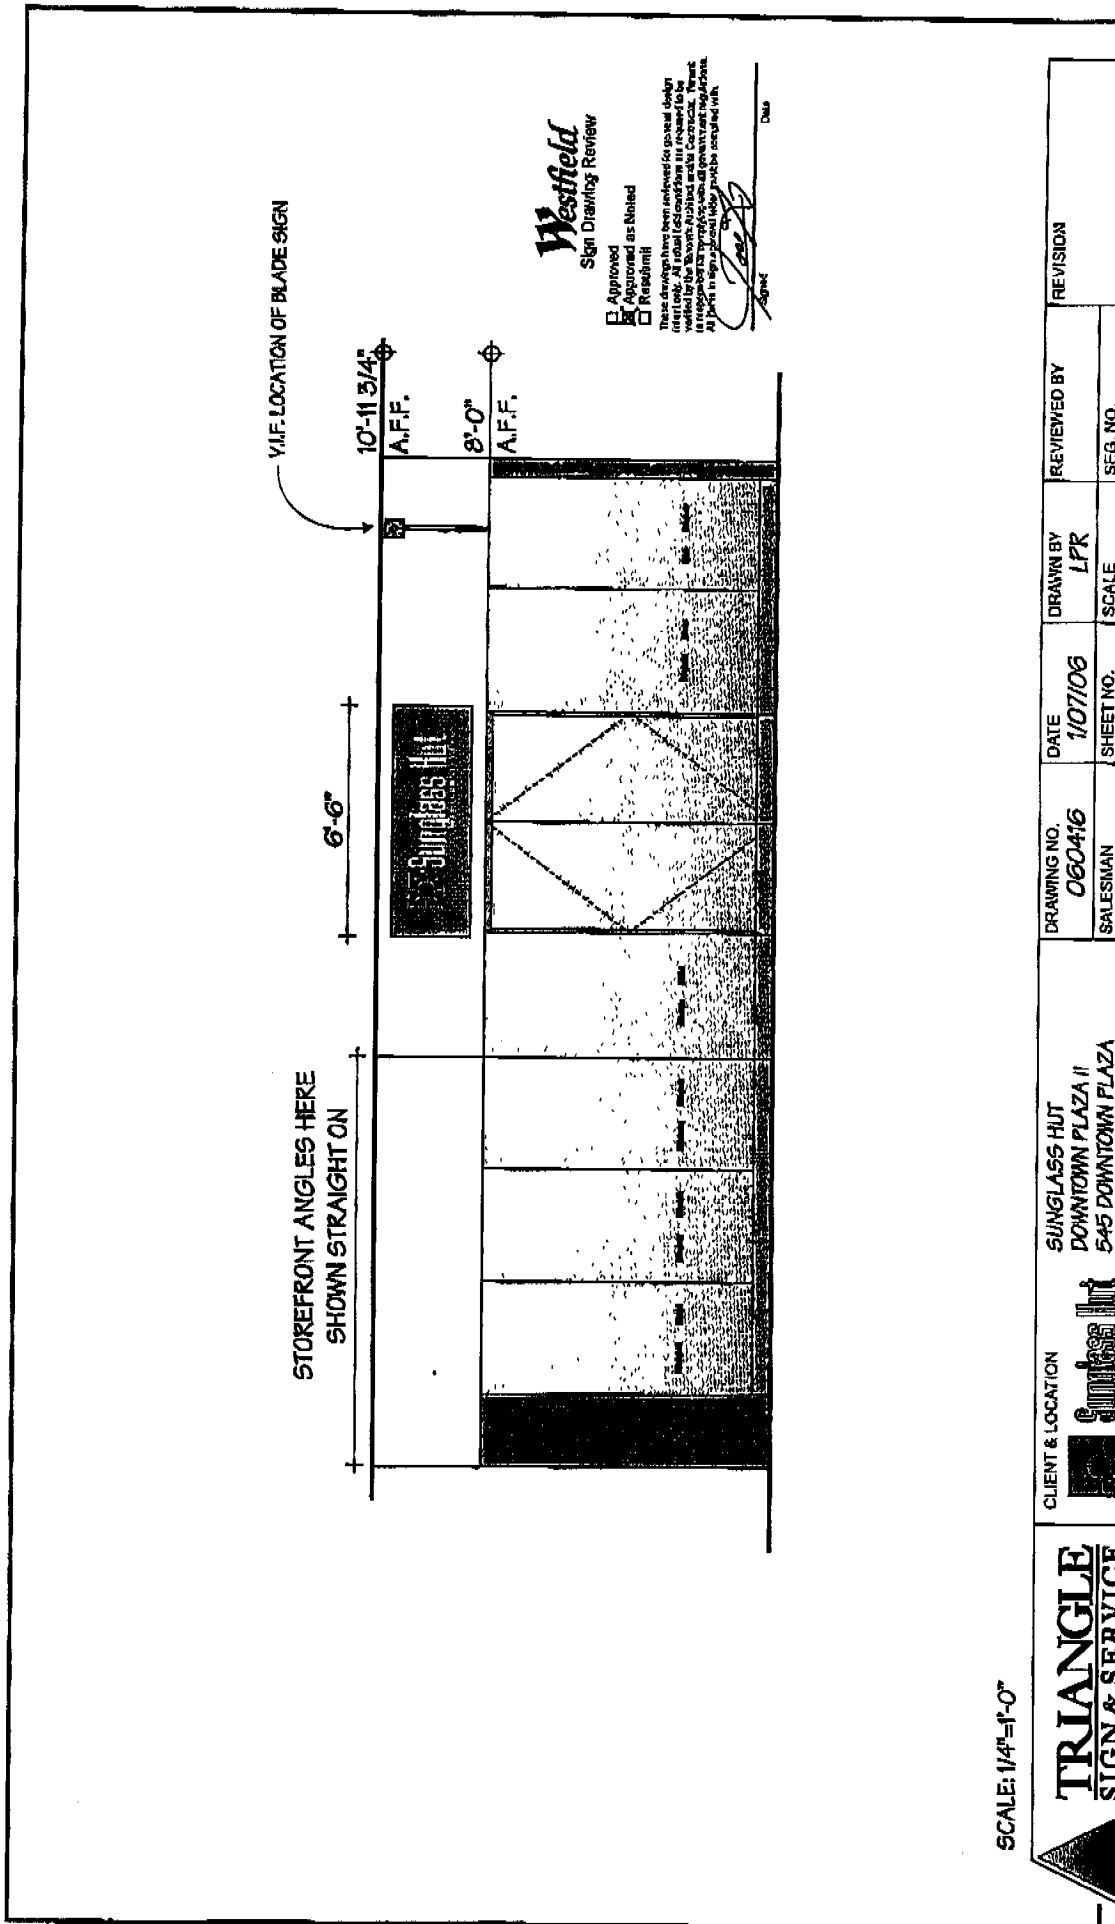

Westfield
Sign Drawing Review

Approved as Noted
 Approved
 Resubmit

This drawing has been prepared for general design information. It is not intended for construction. It is not to be used for any other purpose without the express written consent of the author. The author is not responsible for any errors or omissions in this drawing. All dimensions are in feet and inches unless otherwise noted. All rights reserved.

SCALE: 1/4"=1'-0"

TRIANGLE
SIGN & SERVICE

CLIENT & LOCATION

SUNGLASS HUT
DOWNTOWN PLAZA II
545 DOWNTOWN PLAZA
SACRAMENTO, CA 95814

DRAWING NO.
060416

SALESMAN
S. ALTSHULER

DATE
1/07/06

SHEET NO.
2 OF 2

DRAWN BY
LFR


SCALE
AS NOTED

REVIEWED BY

SEG. NO.

REVISION

11 AZAR COURT / P.O. BOX 24189 BALTIMORE, MARYLAND 21227 - (410) 247-9300 - FAX (410) 247-1944. REPRODUCTION IN WHOLE OR PART PROHIBITED WITHOUT EXPRESS PERMISSION OF TRIANGLES & S

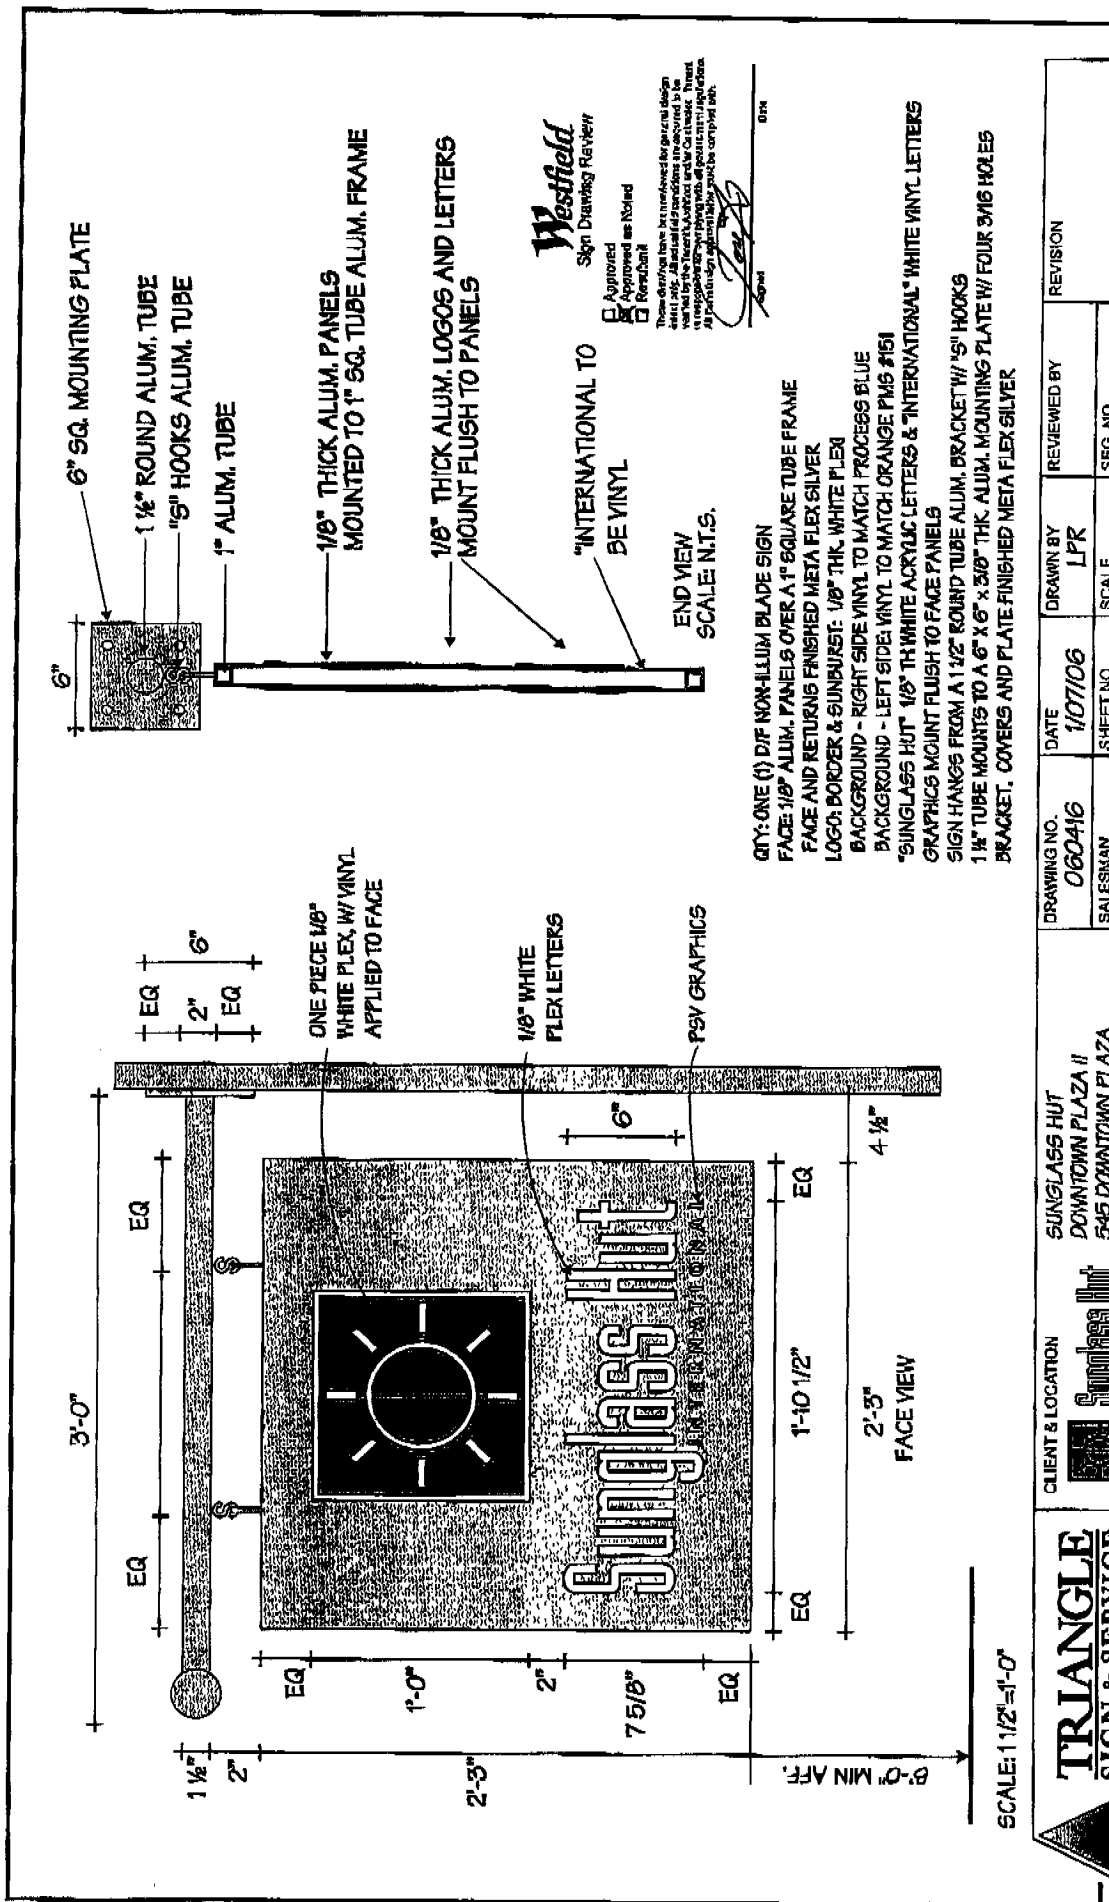

Westfield
Sign Drawing Review

Approved as Noted
Resubmitt

[Signature]

These drawings have been reviewed for general design and construction details. The contractor is responsible for all details not shown. The contractor is responsible for obtaining all necessary permits and for compliance with all applicable codes and regulations. A professional seal is required for all drawings.

QTY: ONE (1) D/F NON-ILLUM BLADE SIGN
FACE: 1/8" ALUM. PANELS OVER A 1" SQUARE TUBE FRAME
FACE AND RETURNING FINISHED META FLEX SILVER
LOGO: BORDER & SUNBURST: 1/8" THK. WHITE FLEX
BACKGROUND - RIGHT SIDE VINYL TO MATCH PROCESS BLUE
BACKGROUND - LEFT SIDE VINYL TO MATCH ORANGE PMS #151
"SUNGLASS HUT" 1/8" TH WHITE ACRYLIC LETTERS & "INTERNATIONAL" WHITE VINYL LETTERS
GRAPHICS MOUNT FLUSH TO FACE PANELS
SIGN HANGS FROM A 1 1/2" ROUND TUBE ALUM. BRACKET W/ "S" HOOKS
1 1/2" TUBE MOUNTS TO A 6" X 6" X 3/8" THK. ALUM. MOUNTING PLATE W/ FOUR 3/16 HOLES
BRACKET, COVERS AND PLATE FINISHED META FLEX SILVER

DRAWING NO. 060416	DATE	1/07/06	DRAWN BY	LPR	REVIEWED BY	REVISION
	SHEET NO.	1 OF 2	SCALE	AS NOTED		
SALESMAN S. ALTSHULER						

CLIENT & LOCATION
 SUNGLASS HUT
 DOWNTOWN PLAZA II
 545 DOWNTOWN PLAZA
 SACRAMENTO, CA 95834

TRIANGLE
SIGN & SERVICE

11 AZAR COURT / P.O. BOX 24186 BALTIMORE, MARYLAND 21227 - (410) 247-5300 - FAX (410) 247-1944 REPRODUCTION IN WHOLE OR PART PROHIBITED WITHOUT EXPRESS PERMISSION OF TRIANGLE S & S