

CITY OF SACRAMENTO

1231 I Street, Sacramento, CA 95814

Permit No: 0505675

Insp Area: 1

Thos Bros: 297H5

Site Address: 1348 40TH ST SAC

Parcel No: 008-0254-004

Sub-Type: REV

Housing (Y/N): N

CONTRACTOR
DENNIS M COLLINS
7450 CARDVALE CA.
ORANGEVALE CA. 95662

OWNER
STEWART MARTHA ANN, TRUSTEE
1348 40TH ST
SACRAMENTO, CA 95819

ARCHITECT

Nature of Work: ADDING CLOSET IN LAUNDRY ROOM, ADD PORTICO OVER FRONT PORCH

CONSTRUCTION LENDING AGENCY: I hereby affirm under penalty of perjury that there is a construction lending agency for the performance of the work for which this permit is issued (Sec. 3097, Civ. C).

Lender's Name _____ Lender's Address _____

LICENSED CONTRACTORS DECLARATION: I hereby affirm under penalty of perjury that I am licensed under provisions of Chapter 9 (commencing with section 7000) of Division 3 of the Business and Professions Code and my license is in full force and effect.

License Class _____ License Number 473403 Date 7/13/05 Contractor Signature *[Signature]*

OWNER-BUILDER DECLARATION: I hereby affirm under penalty of perjury that I am exempt from the contractors License Law for the following reason (Sec. 7031.5, Business and Professions Code; any city or county which requires a permit to construct, alter, improve, demolish, or repair any structure, prior to its issuance, also requires the applicant for such permit to file a signed statement that he or she is licensed pursuant to the provisions of the Contractors License Law (Chapter 9 (commencing with Section 7000) of Division 8 of the Business and Professions Code) or that he or she is exempt therefrom and the basis for the alleged exemption. Any violation of Section 7031.5 by any applicant for a permit subjects the applicant to a civil penalty of not more than five hundred dollars (\$500.00);

I, as a owner of the property, or my employees with wages as their sole compensation, will do the work, and the structure is not intended or offered for sale (Sec. 7044, Business and Professional Code: The Contractors License Law does not apply to an owner of property who builds or improves thereon, and who does such work himself or herself or through his/her own employees, provided that such improvements are not intended or offered for sale. If, however, the building or improvement is sold within one year of completion, the owner-builder will have the burden of proving that the building or improvement was for the purpose of sale.)

I, as owner of the property, am exclusively contracting with licensed contractors to construct the project (Sec. 7044 Business and Professions Code: The Contractors License Law does not apply to an owner of property who builds or improves thereon, and who contracts for such projects with a contractor(s) licensed pursuant to the Contractors License Law).

I am exempt under Sec. _____ B & PC for this reason: _____
Date 7/13/05 Owner Signature *[Signature]*

IN ISSUING THIS BUILDING PERMIT, the applicant represents, and the city relies on the representation of the applicant, that the applicant verified all measurements and locations shown on the application or accompanying drawings and that the improvement to be constructed does not violate any law or private agreement relating to permissible or prohibited locations for such improvements. This building permit does not authorize any illegal location of any improvement or the violation of any private agreement relating to location of improvements.

I certify that I have read this application and state that all information is correct. I agree to comply with all city and county ordinances and state laws relating to building construction and herby authorize representative(s) of this city to enter upon the abovementioned property for inspection purposes.

Date _____ Applicant/Agent Signature _____

WORKER'S COMPENSATION DECLARATION: I hereby affirm under penalty of perjury one of the following declarations:

I have and will maintain a certificate of consent to self-insure for workers' compensation as provided for by Section 3700 of the Labor Code, for the performance of work for which the permit is issued.

I have and will maintain workers' compensation insurance, as required by Section 3700 of the Labor Code, for the performance of the work for which this permit is issued. My workers' compensation insurance carrier and policy number are:

Carrier STATE FUND Policy Number 1768256 Exp Date 08/23/2004

(This section need not be completed if the permit is for \$100 or less) I certify that in the performance of the work for which this permit is issued, I shall not employ any person in any manner so as to become subject to the workers' compensation laws of California and agree that if I should become subject to the workers' compensation provisions of Section 3700 of the Labor Code, I shall forthwith comply with those provisions.

Date 7/13/05 Applicant Signature *[Signature]*

WARNING: FAILURE TO SECURE WORKER'S COMPENSATION COVERAGE IS UNLAWFUL AND SHALL SUBJECT AN EMPLOYER TO CRIMINAL PENALTIES AND CIVIL FINES UP TO ONE HUNDRED THOUSAND DOLLARS (\$100,000) IN ADDITION TO THE COST OF COMPENSATION, DAMAGES AS PROVIDED FOR IN SECTION 3706 OF THE LABOR CODE, INTEREST AND ATTORNEY'S FEE.


THIS PERMIT SHALL EXPIRE BY LIMITATION IF WORK IS NOT COMMENCED WITHIN 180 DAYS.

City of Sacramento Planning Division
PLANNING REVIEW FOR BUILDING PERMIT SUBMITTAL

ADDRESS: 1348 40 th Street	APN: 008-0254-004
DRPB AREA / PUD / SPD: None	ZONING: R-1
EXISTING LAND USE: Single family home with detached garage	
PROPOSED USE: Addition on the rear of home and interior remodel/ covered front porch	
<p>PLANNING STAFF WILL CHECK ONE OR MORE OF THE ITEMS BELOW:</p> <p><input type="checkbox"/> Planning review is NOT required.</p> <p><input type="checkbox"/> Use is NOT allowed; applicant CANNOT submit for plan check.</p> <p><input type="checkbox"/> Requires APPLICATION(s): PC ZA IR ER DR PB</p> <p style="padding-left: 40px;">Required Planning application must be submitted <i>before</i> project can be submitted for plan check.</p> <p><input type="checkbox"/> Application(s) IN PROGRESS:</p> <p style="padding-left: 40px;">Applicant may submit for concurrent building permit plan check, at applicant's risk. Building Division must check with Planning staff and/or SITE before issuing building permit.</p> <p><input type="checkbox"/> Application(s) COMPLETED:</p> <p style="padding-left: 40px;">Building permit must conform to approved plans and comply with all conditions of approval. Do NOT issue building permit prior to end of 10 day appeal period.</p> <p><input checked="" type="checkbox"/> Plans may be submitted for plan check. Plan checker(s) shall confirm compliance with Zoning Ordinance requirements and all applicable development standards <i>prior to issuance</i> of building permit.</p> <p><input checked="" type="checkbox"/> Meets setback & lot coverage requirements as shown on site plan provided.</p> <p><input checked="" type="checkbox"/> Plans to be submitted have been stamped/signed by Planning counter staff.</p> <p><input type="checkbox"/> Route to SITE for plan check and inspection.</p> <p><input type="checkbox"/> Preliminary review ONLY; the information on this form must be reviewed again and confirmed at the time of building permit submittal.</p>	
<p>COMMENTS: Addition meets the setback requirements for the R-1 zone. Total lot coverage is under 24%. (Home 1306, garage 361, covered porch 32, on a 7055 sf lot.) Front porch is maintaining the existing front setback of 57''. No other planning issues are apparent.</p>	
DATE: July 6, 2004 / 07-13-2005	BY: Evan Compton & Pealdwell


REVISION OF 7/13/05

1/2

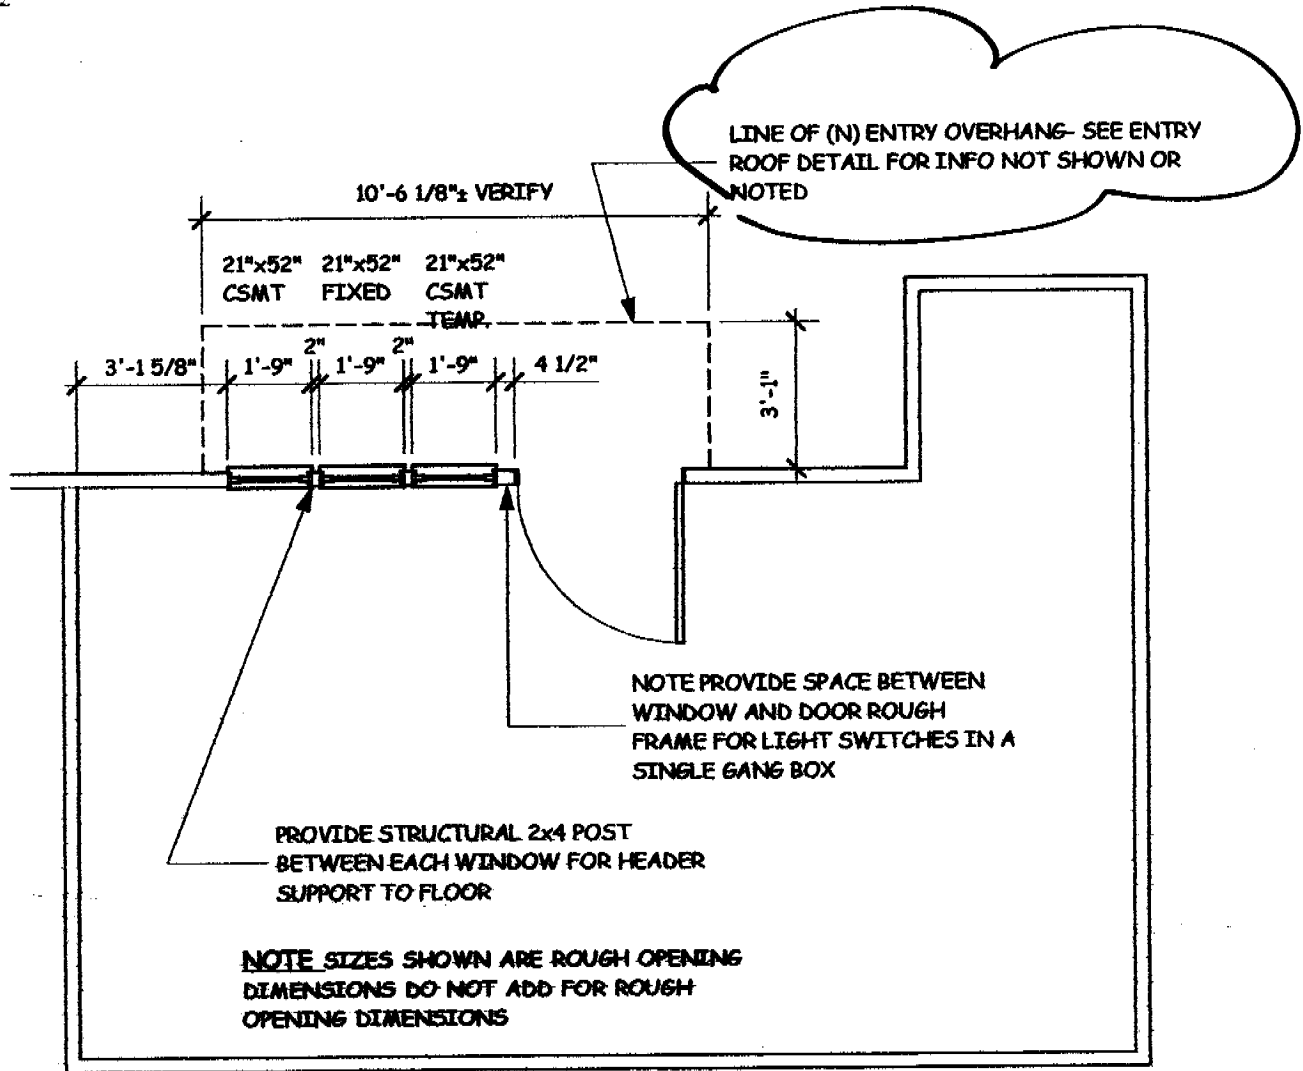

1 LIVING RM FLOOR PLAN
A2 Scale: 1/4" = 1'-0"

Per # 0410793

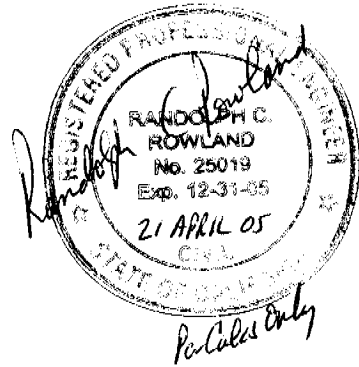


RESIDENCE REMODEL FOR:
GEORGE MILLS
1348 40th STREET
SACRAMENTO, CA 95819

ISSUED
JUL 13 2005

CITY COPY

P 9 1/2

Sacramento Building Division

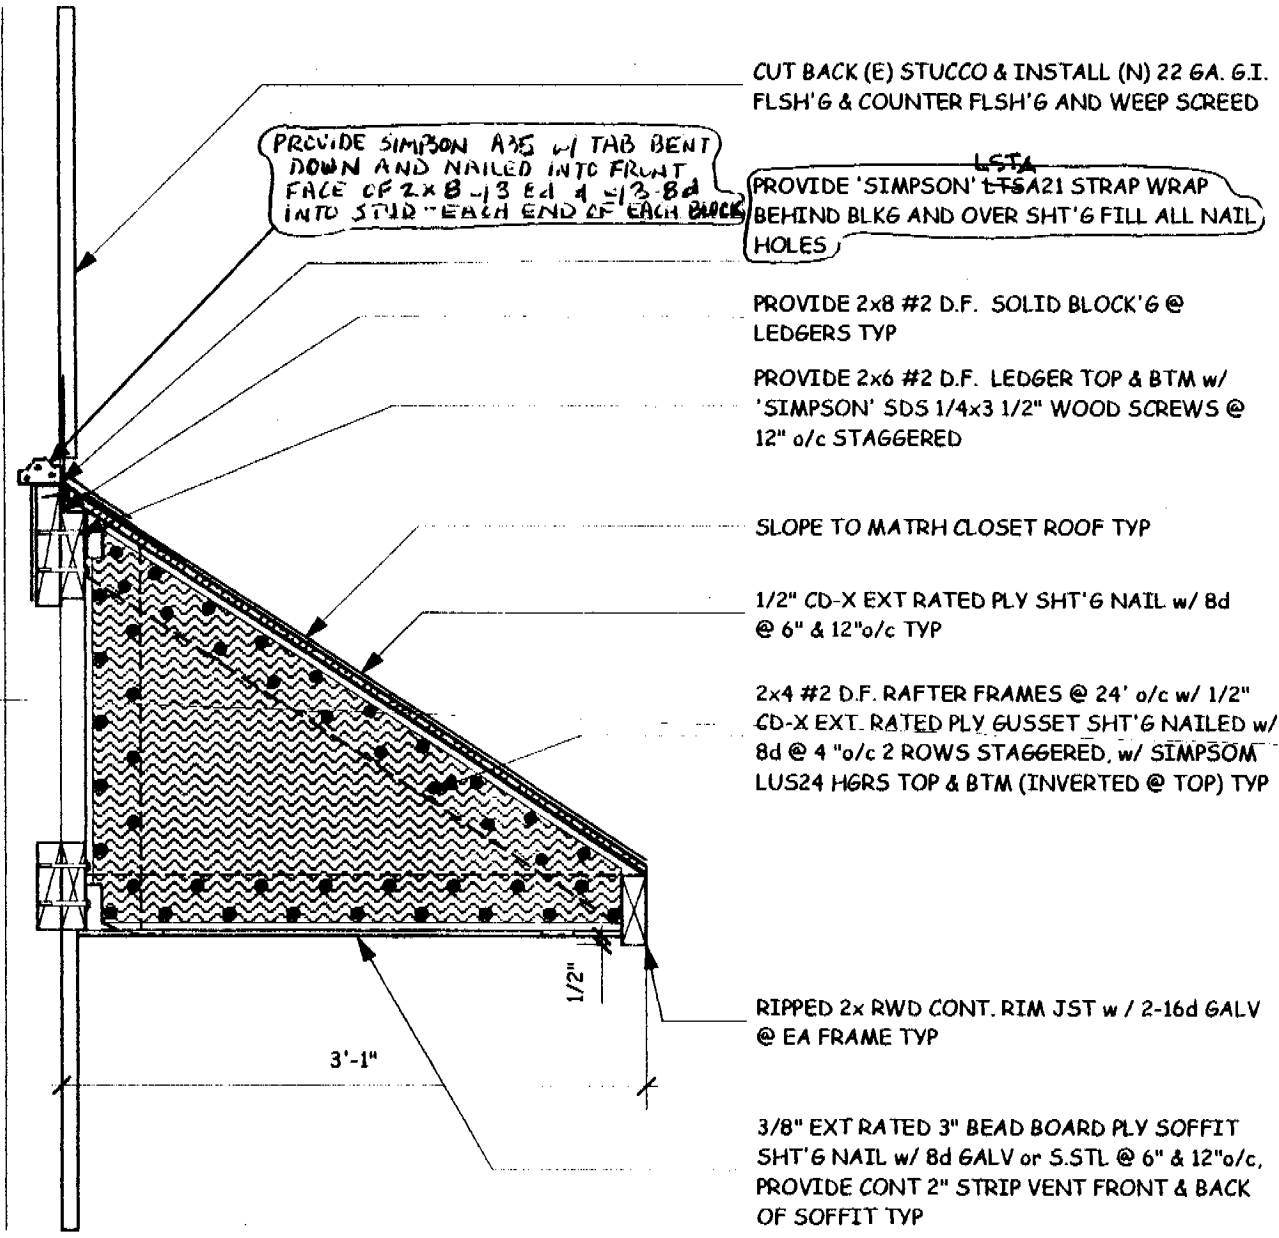

ENTRY ROOF DETAIL SC 1"=1'-0"

RESIDENCE REMODEL FOR:
GEORGE MILLS
1348 40th STREET
SACRAMENTO, CA 95819

ISSUED
JUL 13 2005

CITY COPY

P92/2