CITY OF SACRAMENTO		Permit No:	0506410
231 I Street, Sacramento, CA 9	5814	Insp Area:	2 ************************************
		Thos Bros:	316J6
	I DD CAC	O-1-1-Tr-	DED CALL
Site Address: 6200 GREENHAVEN Parcel No: 030-0361-008	UNIT# 209 AND 210	Sub-Type: Housing (Y/N)	
CONTRACTOR	<u>OWNER</u> CP PARK TOWNHOMES LLC	<u>ARCHITECT</u>	
	1000 SAMSOME ST SAN FRANCISCO, CA 94111		
Nature of Work: REPAIR SECONI	O STORY BALCONIES IN APART	MENT UNIT# 209 A	ND 210. ENGINE
APPROVED UNDER# 0504543			i janaan in
CONSTRUCTION LENDING AGENCY: ne work for which this permit is issued (Sec. 3097, C		is a construction lending agenc	y for the performance of
ender's Name	Lender's Address		
ICENSED CONTRACTORS DECLARA commencing with section 7000) of Division 3 of the			provisions of Chapter 9
icense Class License Number Date	•	· · · · · · · · · · · · · · · · · · ·	
OWNER-BUILDER DECLARATION: I he			
undred dollars (\$500.00);		MAY 0 6 2005	the state of the s
I, as a owner of the property, or my employed ale (Sec. 7044, Business and Professional Code: The does such work himself or herself or through him building or improvement is sold within one year	s/her own employees, provided that such improve	the work, and the structure is the owner of property when builds o	r improves thereon, and ed for sale. If, however,
I, as a owner of the property, or my employed ale (Sec. 7044, Business and Professional Code: The vho does such work himself or herself or through him building or improvement is sold within one year the purpose of sale.)	he Contractors License Law does not apply to an ois/her own employees, provided that such improve of completion, the owner-builder will have the bur	the work, and the structure is the owner of property, who builds of the owners are not intended or offer reden of proving that he/she did to	r improves thereon, and ed for sale. If, however, not build or improve for
I, as a owner of the property, or my employed ale (Sec. 7044, Business and Professional Code: The vho does such work himself or herself or through himself or herself or hersel	he Contractors License Law does not apply to an ois/her own employees, provided that such improve of completion, the owner-builder will have the bur ontracting with licensed contractors to construct to	the work, and the structure is the owner of property, when builds ownents are not intended or offer iden of proving that he/she did the project (Sec. 7044, Business	r improves thereon, and ed for sale. If, however, not build or improve for and Professions Code:
I, as a owner of the property, or my employed ale (Sec. 7044, Business and Professional Code: The who does such work himself or herself or through him the building or improvement is sold within one year of the purpose of sale.) I, as owner of the property, am exclusively come contractors License Law does not apply to an owner of the Contractors License Law).	he Contractors License Law does not apply to an ois/her own employees, provided that such improve of completion, the owner-builder will have the bur ontracting with licensed contractors to construct to	the work, and the structure is the owner of property, when builds ownents are not intended or offer iden of proving that he/she did the project (Sec. 7044, Business	r improves thereon, and ed for sale. If, however, not build or improve for and Professions Code:
ale (Sec. 7044, Business and Professional Code: The who does such work himself or herself or through himself or herself or	he Contractors License Law does not apply to an dis/her own employees, provided that such improve of completion, the owner-builder will have the burn ontracting with licensed contractors to construct the owner of property who builds or improves thereon,	the work, and the structure is the owner of property, when builds ownents are not intended or offer iden of proving that he/she did the project (Sec. 7044, Business	r improves thereon, and ed for sale. If, however, not build or improve for and Professions Code:
I, as a owner of the property, or my employed ale (Sec. 7044, Business and Professional Code: The who does such work himself or herself or through himself or herself or h	he Contractors License Law does not apply to an eis/her own employees, provided that such improve of completion, the owner-builder will have the bure ontracting with licensed contractors to construct the wner of property who builds or improves thereon, B & PC for this reasons Owner Signature plicant represents, and the city relies on the represent or accompanying drawings and that the improved locations for such improvements. This building	the work, and the structure is recovered to property, who poiles of the ments are not intended or offer iden of proving that he/she did the project (Sec. 7044, Business and who contracts for such project is entation of the applicant, that overnent to be constructed does	r improves thereon, and ed for sale. If, however, not build or improve for and Professions Code: ects with a contractor(s) the applicant verified all a not violate any law or
I, as a owner of the property, or my employed ale (Sec. 7044, Business and Professional Code: The who does such work himself or herself or through him building or improvement is sold within one year of the purpose of sale.) I, as owner of the property, am exclusively continuous License Law does not apply to an owner of the Contractors License Law does not apply to an owner of the Contractors License Law). I am exempt under Sec. I a	he Contractors License Law does not apply to an dis/her own employees, provided that such improve of completion, the owner-builder will have the burn ontracting with licensed contractors to construct the water of property who builds or improves thereon, B & PC for this reason. Owner Signature plicant represents, and the city relies on the represent or accompanying drawings and that the improved locations for such improvements. This building the relating to location of improvements.	the work; and the structure is reported to properly who by builds of the ments are not intended or offer reden of proving that he/she did the project (Sec. 7044, Business and who contracts for such project sentation of the applicant, that by the project is entation of the applicant is entation of th	r improves thereon, and ed for sale. If, however, not build or improve for s and Professions Code: ects with a contractor(s) the applicant verified all s not violate any law or y illegal location of any and state laws relating to
I, as a owner of the property, or my employed ale (Sec. 7044, Business and Professional Code: The who does such work himself or herself or through himself or herself or the contractors License Law does not apply to an ovicensed pursuant to the Contractors License Law). I am exempt under Sec. I am	he Contractors License Law does not apply to an dis/her own employees, provided that such improve of completion, the owner-builder will have the burn ontracting with licensed contractors to construct the water of property who builds or improves thereon, B & PC for this reason. Owner Signature plicant represents, and the city relies on the represent or accompanying drawings and that the improved locations for such improvements. This building the relating to location of improvements.	the work; and the structure is reported to properly who by builds of the ments are not intended or offer reden of proving that he/she did the project (Sec. 7044, Business and who contracts for such project sentation of the applicant, that by the project is entation of the applicant is entation of th	r improves thereon, and ed for sale. If, however, not build or improve for s and Professions Code: ects with a contractor(s) the applicant verified all s not violate any law or y illegal location of any and state laws relating to
I, as a owner of the property, or my employed ale (Sec. 7044, Business and Professional Code: The vho does such work himself or herself or through him building or improvement is sold within one year of the purpose of sale.) I, as owner of the property, am exclusively compared to the Contractors License Law does not apply to an oversed pursuant to the Contractors License Law). I am exempt under Sec. Out Out N ISSUING THIS BUILDING PERMIT, the application and locations shown on the application rivate agreement relating to permissible or prohibite inprovement or the violation of any private agreement certify that I have read this application and state that wilding construction and herby authorize representation at the same state of the consequence of the consequenc	he Contractors License Law does not apply to an eis/her own employees, provided that such improve of completion, the owner-builder will have the build ontracting with licensed contractors to construct the war of property who builds or improves thereon, B & PC for this reason. Owner Signature plicant represents, and the city relies on the represent or accompanying drawings and that the improved locations for such improvements. This building the relating to location of improvements. It all information is correct. I agree to comply with ive(s) of this city to enter upon the abovement of Applicant/Agent Signature	the work, and the structure is recovered to property, where builds of the ments are not intended or offer riden of proving that he/she did not the project (Sec. 7044, Business and who contracts for such project and who contracts for such project in the project is entation of the applicant, that exement to be constructed does not authorize and all city and county ordinances the project in the p	r improves thereon, and ed for sale. If, however, not build or improve for and Professions Code: ects with a contractor(s) the applicant verified all s not violate any law or y illegal location of any and state laws relating to es.
I, as a owner of the property, or my employed ale (Sec. 7044, Business and Professional Code: The who does such work himself or herself or through him the building or improvement is sold within one year of the purpose of sale.) I, as owner of the property, am exclusively confine Contractors License Law does not apply to an owner of the Contractors License Law does not apply to an owner of the Contractors License Law). I am exempt under Sec. I am exempt un	he Contractors License Law does not apply to an asi/her own employees, provided that such improve of completion, the owner-builder will have the burst ontracting with licensed contractors to construct the war of property who builds or improves thereon, as PC for this reason. Owner Signature Discant represents, and the city relies on the represent or accompanying drawings and that the improved locations for such improvements. This building the relating to location of improvements. At all information is correct. I agree to comply with tive(s) of this city to enter upon the abovementions. Applicant/Agent Signature ATION: I hereby affirm under penalty of perjuryent to self-insure for workers' compensation as proon insurance, as required by Section 3700 of the	the work; and the structure is the work owner of property wher builds of the ments are not intended or offer reden of proving that he/she did the project (Sec. 7044, Business and who contracts for such project in the project of the applicant, that overnent to be constructed does not authorize and permit does not authorize and permit does not authorize and permit inspection purpose of the following declaration ovided for by Section 3700 of	r improves thereon, and ed for sale. If, however, not build or improve for and Professions Code: ects with a contractor(s) the applicant verified all a not violate any law or y illegal location of any and state laws relating to ees.
I, as a owner of the property, or my employed ale (Sec. 7044, Business and Professional Code: The who does such work himself or herself or through him the building or improvement is sold within one year of the purpose of sale.) I, as owner of the property, am exclusively confine Contractors License Law does not apply to an owner of the Contractors License Law does not apply to an owner of the Contractors License Law). I am exempt under Sec. I am exempt un	he Contractors License Law does not apply to an asi/her own employees, provided that such improve of completion, the owner-builder will have the burst ontracting with licensed contractors to construct the war of property who builds or improves thereon, as PC for this reason. Owner Signature Discant represents, and the city relies on the represent or accompanying drawings and that the improved locations for such improvements. This building the relating to location of improvements. At all information is correct. I agree to comply with tive(s) of this city to enter upon the abovementions. Applicant/Agent Signature ATION: I hereby affirm under penalty of perjuryent to self-insure for workers' compensation as proon insurance, as required by Section 3700 of the	the work; and the structure is the work owner of property wher builds of the ments are not intended or offer reden of proving that he/she did the project (Sec. 7044, Business and who contracts for such project in the project of the applicant, that overnent to be constructed does not authorize and permit does not authorize and permit does not authorize and permit inspection purpose of the following declaration ovided for by Section 3700 of	r improves thereon, and ed for sale. If, however, not build or improve for and Professions Code: ects with a contractor(s) the applicant verified all a not violate any law or y illegal location of any and state laws relating to ees.
I, as a owner of the property, or my employed ale (Sec. 7044, Business and Professional Code: The who does such work himself or herself or through himself or herself or herself or herself or herself or her contractors License Law does not apply to an ovicensed pursuant to the Contractors License Law). I am exempt under Sec. I am exempt un	he Contractors License Law does not apply to an eis/her own employees, provided that such improve of completion, the owner-builder will have the build ontracting with licensed contractors to construct the owner of property who builds or improves thereon, as PC for this reason. Owner Signature plicant represents, and the city relies on the represent of or accompanying drawings and that the improved locations for such improvements. This building the relating to location of improvements. It all information is correct. I agree to comply with ive(s) of this city to enter upon the abovement of the property of the complete that the superior of the subject to the workers' compensation as property of the subject to the workers' compensation laws of Camping Superior of the subject to the workers' compensation laws of Camping Superior of the subject to the workers' compensation laws of Camping Superior of the subject to the workers' compensation laws of Camping Superior of the subject to the workers' compensation laws of Camping Superior of the subject to the workers' compensation laws of Camping Superior of the subject to the workers' compensation laws of Camping Superior of the subject to the workers' compensation laws of Camping Superior of the subject to the workers' compensation laws of Camping Superior of the subject to the workers' compensation laws of Camping Superior of the subject to the workers' compensation laws of Camping Superior of the subject to the workers' compensation laws of Camping Superior of the subject to the workers' compensation laws of Camping Superior of the subject to the workers' compensation laws of Camping Superior of the subject to the workers' compensation laws of Camping Superior of the subject to the workers' compensation laws of Camping Superior of the subject to the workers' compensation laws of Camping Superior of the subject to the	the work, and the structure is the work owner of property wher builds of ments are not intended or offer iden of proving that he/she did not be project (Sec. 7044, Business and who contracts for such project in the applicant, that overnent to be constructed does not authorize and all city and bounty ordinances of the project inspection purposed one of the following declaration ovided for by Section 3700 of the Exp Date mance of the work for which this alifornia and agree that if I should be mance of the work for which this alifornia and agree that if I should be made of the work for which this alifornia and agree that if I should be made of the work for which this alifornia and agree that if I should be made of the work for which this alifornia and agree that if I should be made of the work for which this alifornia and agree that if I should be made of the work for which this alifornia and agree that if I should be made of the work for which this alifornia and agree that if I should be made of the work for which this alifornia and agree that if I should be made of the work for which this alifornia and agree that if I should be made of the work for which this alifornia and agree that if I should be made of the work for which this alifornia and agree that if I should be made of the work for which the should be made of the work for which the should be made of the work for which the should be made of the work for which the should be made of the work for which the should be made of the work for which the should be made of the work for which the should be made of the work for which the should be made of the work for which the should be made of the work for which the should be made of the work for which the work for whi	r improves thereon, and ed for sale. If, however, not build or improve for and Professions Code: ects with a contractor(s) the applicant verified all s not violate any law or y illegal location of any and state laws relating to ies. Institute the Labor Code, for the ee of the work for which is permit is issued, Ishall
I, as a owner of the property, or my employed ale (Sec. 7044, Business and Professional Code: The who does such work himself or herself or through himself or herself or the Contractors License Law does not apply to an ovicensed pursuant to the Contractors License Law). I am exempt under Sec.	he Contractors License Law does not apply to an eis/her own employees, provided that such improve of completion, the owner-builder will have the build ontracting with licensed contractors to construct the owner of property who builds or improves thereon, as PC for this reason. Owner Signature plicant represents, and the city relies on the represent of or accompanying drawings and that the improved locations for such improvements. This building the relating to location of improvements. It all information is correct. I agree to comply with ive(s) of this city to enter upon the abovement of the property of the complete that the superior of the subject to the workers' compensation as property of the subject to the workers' compensation laws of Camping Superior of the subject to the workers' compensation laws of Camping Superior of the subject to the workers' compensation laws of Camping Superior of the subject to the workers' compensation laws of Camping Superior of the subject to the workers' compensation laws of Camping Superior of the subject to the workers' compensation laws of Camping Superior of the subject to the workers' compensation laws of Camping Superior of the subject to the workers' compensation laws of Camping Superior of the subject to the workers' compensation laws of Camping Superior of the subject to the workers' compensation laws of Camping Superior of the subject to the workers' compensation laws of Camping Superior of the subject to the workers' compensation laws of Camping Superior of the subject to the workers' compensation laws of Camping Superior of the subject to the workers' compensation laws of Camping Superior of the subject to the workers' compensation laws of Camping Superior of the subject to the workers' compensation laws of Camping Superior of the subject to the workers' compensation laws of Camping Superior of the subject to the	the work, and the structure is the work owner of property wher builds of ments are not intended or offer iden of proving that he/she did not be project (Sec. 7044, Business and who contracts for such project in the applicant, that overnent to be constructed does not authorize and all city and bounty ordinances of the project inspection purposed one of the following declaration ovided for by Section 3700 of the Exp Date mance of the work for which this alifornia and agree that if I should be mance of the work for which this alifornia and agree that if I should be made of the work for which this alifornia and agree that if I should be made of the work for which this alifornia and agree that if I should be made of the work for which this alifornia and agree that if I should be made of the work for which this alifornia and agree that if I should be made of the work for which this alifornia and agree that if I should be made of the work for which this alifornia and agree that if I should be made of the work for which this alifornia and agree that if I should be made of the work for which this alifornia and agree that if I should be made of the work for which this alifornia and agree that if I should be made of the work for which this alifornia and agree that if I should be made of the work for which the should be made of the work for which the should be made of the work for which the should be made of the work for which the should be made of the work for which the should be made of the work for which the should be made of the work for which the should be made of the work for which the should be made of the work for which the should be made of the work for which the should be made of the work for which the work for whi	r improves thereon, and ed for sale. If, however, not build or improve for and Professions Code: ects with a contractor(s) the applicant verified all s not violate any law or y illegal location of any and state laws relating to ies. Institute the Labor Code, for the ee of the work for which is permit is issued, Ishall



Downtown Permit Center 1231 | Street, Suite 200 Sacramento, CA 95814 Help Line: 1-916-264-5656

CITY OF SACRAMENTO DEVELOPMENT SERVICES DEPARTMENT BUILDING DIVISION www.cityofsacramer.to.org

North Permit Center 2101 Arena Blvd., Suite 200 Sacramento, CA 95834 Inspection: 1-916-808-4677

OWNER BUILDER VERIFICATION

and the second second	_ !			Lild	will work	~~~
Check one below -	. I or my immediate	е јаппну (рајенц	, spouse,	or cmia)	wm bem	OITH
CHECK OHE DESC.	1,01,000	7 34		-	-	


- all the work authorized by this permit.
- a portion of the work. none of the work.

If B or C is checked, complete 2 or 3 below.

2. A State licensed contractor (*) will be hired to do:

		all of the authorized work.	a portion of the authorized work.
	Name	TO BE DETERMEN	Phone
	Address	OUT FOR BED	
	Type of Work		
		•	
	Name		Phone
	Address		
	Type of Work		
	Name		Phone
•			
	Type of Work		
	Name		Phone
	Address		
	Type of Work		
3.	Certificate of Wor	kers Compensation must be on file at this office.	to perform all or portions of the authorized work. A
I decla the rev	ere under penalty of perse side of this formation Signed: Property		ead and understand the owner-builder information on
	Date 5-6-	OS Case No	Permit No. <u>0506410</u>
	Job Address <u>O</u>	200 OREENHAUEN SHOW	marpage Cred

Note: * Information regarding unknown contractors or change in subcontractors shall be submitted to the Building Inspection field office.

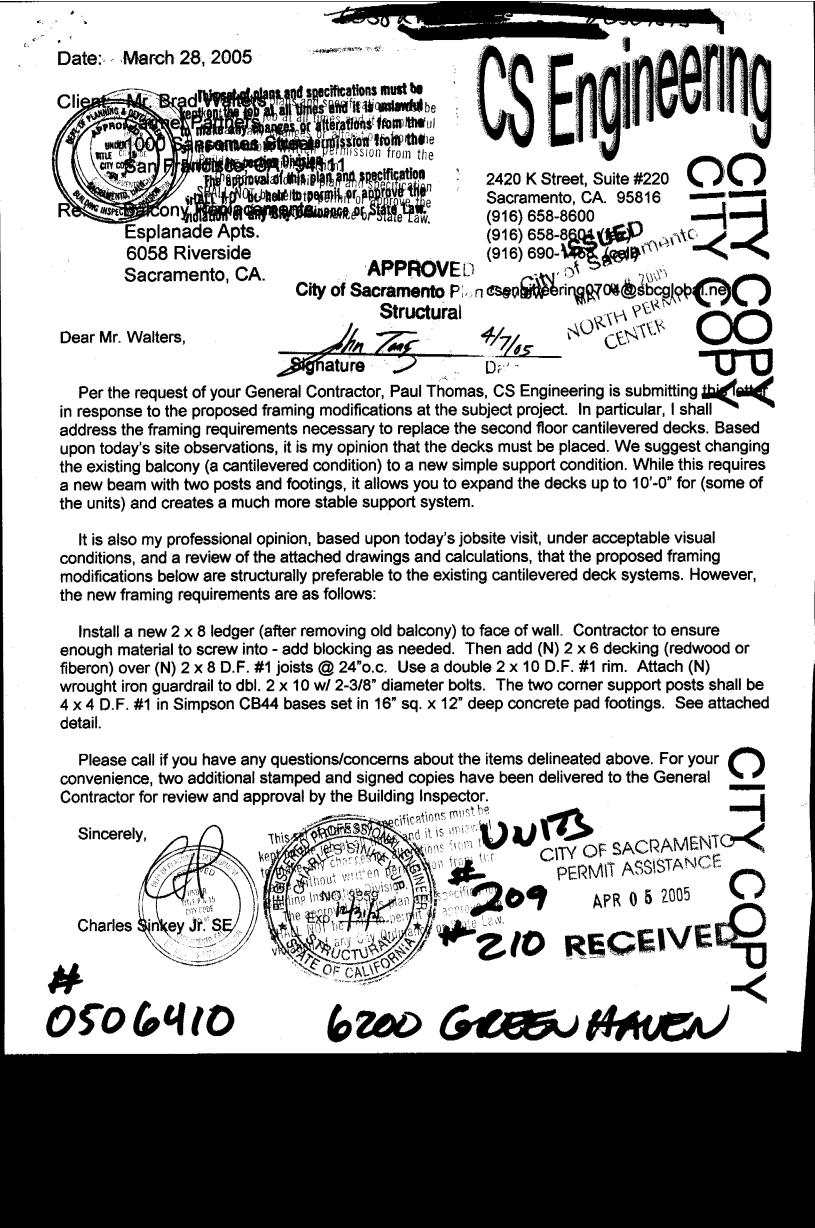

CS Engineering

2420 K Steet, Suite 220; Sacramento, CA. 95816 Phone (916) 658-8600 Fax (916) 658-8601


JOB_ESPLA	LOE APT.	<u>چ</u> ـــــ	
SHEET NO.	<u> </u>	 OF	2
CALCULATED BY	CS	DATE	3/05
CHECKED BY		_ DATE	

PATION *2 Apt # 200 + 207 TO REPLACE CANT. BALCONT W/ SIMPLE SPAN DECK LONDS DL = 10 PSF LL = 40 PSF TL = 50 PSF TL = 10 0 SPCG = 24 C. TW = 00 PSF ALL = 15 (100)(5)/95 = 79 IN SELED THE ("X 15/2600 = 98 IN IN INTERVIEW SIST. I = 48 NORTH TEX BOWN SPAN = 2'0' W = 50 PSF (6) = 1545 THE ("X 15/2600 = 100 IN INTERVIEW BOWN SPAN = 2'0' W = 50 PSF (6) = 1545 THE ("X 15/2600 = 100 IN INTERVIEW BOWN SPAN = 2'0' W = 50 PSF (6) = 1545 THE ("X 15/2600 = 100 IN INTERVIEW LEDGER W = 250 PSF PSF (N) 10' SQ. CONC. PTG. LEDGER W = 250 PSF PSF (138) = 383 * LEDGER W = 250 PSF PSF PSF (138) = 383 * LEDGER W = 250 PSF PSF (138) = 383 * LEDGER W = 250 PSF PSF PSF (138) = 383 * LEDGER W = 250 PSF PSF PSF (138) = 383 * LEDGER W = 250 PSF PSF PSF PSF (138) = 383 * LEDGER W = 250 PSF	TO REPLACE CANT. BALCONT W/ SIMPLE SPAN DEZK LONDG DL = 10 PSF L-40 PSF TC=50 PSF JOISTG SPAN = 10.0" SPCG= 24°C. Tr = 100 PCF AX = 15 (100)(5)/95 = 7.9 In Section (2×8 P.F.) Sr=1.5 (1)(10)/1150 = 13.0 In Section (2×8 P.F.) Tp= (1)(10)/1150 = 13.0 In Section (2×8 P.F.) Tp= (1)(10)/1150 = 38 IN IN OF THE INTER BELLIN SPAN = 12.0" W= 50 PF (60) 250 PCF BELLIN SPAN = 12.0" W= 50 PF (60) 250 PCF
TO REPLACE CANT. BALCONT W/ SIMPLE SPAN DECK LONDS DU = 10 PSF UL = 40 PSF TL = 50 PSF AL = 15 (100)(G)/95 = 79 IN SQUED INDEX 2×8 PF - 1 SL = 15 (100)(G)/95 = 13.0 IN OF SQUED INDEX 2×8 PF - 1 SL = 15 (100)(G)/95 = 13.0 IN OF SQUED INDEX 2×8 PF - 1 SL = 15 (100)(G)/95 = 13.0 IN OF SQUED INDEX 2×8 PF - 1 BELLIN SPAN = 12.0" TW = 50 PSF (F) PSF TO THE INDEX AL = 15 (250)(G)/95 = 83.7 IN OF SQUED INDEX SL = 15 (100)(G)/95 = 83.7 IN OF SQUED INDEX SL = 15 (100)(G)/95 = 83.7 IN OF SQUED INDEX TL = (100)(G)/95 = 83.7 IN OF SQUED INDEX SL = 15 (100)(G)/95 = 83.7 IN OF SQUED INDEX SL = 15 (100)(G)/95 = 83.7 IN OF SQUED INDEX SL = 15 (100)(G)/95 = 83.7 IN OF SQUED INDEX SL = 15 (100)(G)/95 = 100 IN OF SQUED INDEX SL = 1	TO PEPLACE CANT. BALCONT W/ SIMPLE SPEND DECK LONDS DL = 10 PSP LL=40 PSP TC=50 PSP JOISTES SPEND = 10.0° SPCG= 24%. Tr=100 PCP AX = 15 (100)(5)/95 = 7.9 IN? SX=15 (1)(10) E/1150 = 13.0 IN; TX = (4) X-)3/2600 = 38 INA INN 10 PT PARTY S=13.1 I=48 BELLIN SPAN = 12.0° W= 50 PSP (EX) = 100 PCP
LOADS DL = 10 PSF	LONDS DL = 10 PSF LC40 PSF TC = 50 PSF AL = 10! 0" SPCG = 24.2. The 100 PCF AL = 15 (100)(5)/95 = 7.9 IN? SPE = 1.5 (100)(5)/95 = 13.0 IN. ISBUED MORE 2x8 P.F. 1 SPE = (100)(100)(1150) = 13.0 IN. ISBUED MORE 2x8 P.F. 1 TP = (100)(100)(1150) = 13.0 IN. ISBUED MORE 2x8 P.F. 1 TP = (100)(100)(1150) = 13.0 IN. ISBUED MORE 2x8 P.F. 1 TP = (100)(100)(1150) = 13.0 IN. ISBUED MORE 1. II = 48 INDER 1. II = 48
JOISTE SPAN = 10'0" SPCG = 24'2, The 100 RP AR = 15 (100)(5)/95 = 79 IN SR=15 (100)(5)/95 = 13.0 IN OF SACTAMORY 2×8 DF. 1 SR=15 (1)(10)2/1150 = 13.0 IN OF SACTAMORY 5=13.1 I=48 TR= (1)2/2600 = 38 IN INDRITION SPAN = 12'0" W= 50 RP (40) 250 PP AR = 15 (250)(6)/95 = 83.7 IN ISE 4 12 DF. 1 IN IN IN SPAN = 12'0" W= 50 RP (40) 250 PP AR = 15 (250)(6)/95 = 83.7 IN ISE 4 12 DF. 1 IN	$T_{c} = 50$ Res $T_{c} = 10^{10}$ of $S_{c} = 24$ c. $T_{c} = 100$ PCF $T_{c} = 15 (100)(5)/95 = 7.9 \text{ max}$ $T_{c} = 15 (100)(5)/95 = 7.9 \text{ max}$ $T_{c} = 15 (100)(5)/95 = 13.0 \text{ max}$ $T_{c} = 15 (10$
JOISTS SPAN = 10'0" SPCG = 24 % . TO P. P. AR = 1.5 (100)(5)/95 = 79 IN . SR = 1.5 (100)(6)/95 = 13.0 IN . SR = 1.5 (100)(100)(1150) = 13.0 IN . TR = (100)(100)(1150) = 13.0 IN . TR = (100)(100)(1150) = 13.0 IN . TR = (100)(100)(1150) = 13.0 IN . BEAM SPAN = 12'0" W= 50RF (60) 150 P. F. AR = 15(250)(60)/95 = 83.7 IN . SR 15 (100)(12) / 1000 = 54.0 IN . SR 15 (100)(12) / 1000 = 54.0 IN . AR = 781. CX12 R.F. IN IN . LEDGER W= 250 R.F. PENT ON 16'50. CONC. PIG. LEDGER W= 250 R.F. PENT ON 16'50. CONC. PIG. LEDGER W= 250 R.F. DENT ON 16'50. CONC. PIG.	Joistes SPAN = 10° . 0° SPCG = 24° . $Tr = 100 \text{ Rp}$ $A_{K} = 15(100)(5)/95 = 7.9 \text{ m/s}$ $S_{K} = 1.5(100)(5)/95 = 13.0 \text{ m/s}$ $S_{K} = 1$
$A_{1} = 5(100)(5)/95 = 7.9 \text{ m}^{2}$ $S_{2} = 5(100)(5)/95 = 3.0 \text{ m}^{2}$ $S_{3} = 5(100)(5)/1950 = 3.0 \text{ m}^{2}$ $S_{4} = 5(100)(5)/1950 = 3.0 \text{ m}^{2}$ $S_{5} = 5(100)(5)/1950 =$	$Ap = 1.5(100)(5)/95 = 7.9 \text{ In}^{2}$ $Sp = 1.5(100)(5)/95 = 13.0 \text{ In}^{2}$ $Sp = $
$T_{\mu} = (\ \) \times \frac{1}{2600} = \frac{38}{100} \text{ MNN} \times \frac{1}{200} \times \frac{1}{200} = \frac{1}{200} \times $	$T_{p} = (4) \times 7^{3} / 2600 = 38 \text{ MAY MAY S=13.1 I = 48}'$ $R_{p} = (4) \times 7^{3} / 2600 = 38 \text{ MAY MAY S=13.1 I = 48}'$ $R_{p} = (4) \times 7^{3} / 2600 = 38 \text{ MAY MAY S=13.1 I = 48}'$ $R_{p} = (4) \times 7^{3} / 2600 = 38 \text{ MAY MAY S=13.1 I = 48}'$ $R_{p} = (4) \times 7^{3} / 2600 = 38 \text{ MAY MAY S=13.1 I = 48}'$ $R_{p} = (4) \times 7^{3} / 2600 = 38 \text{ MAY MAY S=13.1 I = 48}'$ $R_{p} = (4) \times 7^{3} / 2600 = 38 \text{ MAY MAY S=13.1 I = 48}'$ $R_{p} = (4) \times 7^{3} / 2600 = 38 \text{ MAY MAY S=13.1 I = 48}'$ $R_{p} = (4) \times 7^{3} / 2600 = 38 \text{ MAY MAY S=13.1 I = 48}'$ $R_{p} = (4) \times 7^{3} / 2600 = 38 \text{ MAY MAY S=13.1 I = 48}'$ $R_{p} = (4) \times 7^{3} / 2600 = 38 \text{ MAY MAY S=13.1 I = 48}'$ $R_{p} = (4) \times 7^{3} / 2600 = 38 \text{ MAY MAY S=13.1 I = 48}'$ $R_{p} = (4) \times 7^{3} / 2600 = 38 \text{ MAY MAY S=13.1 I = 48}'$ $R_{p} = (4) \times 7^{3} / 2600 = 38 \text{ MAY MAY S=13.1 I = 48}'$ $R_{p} = (4) \times 7^{3} / 2600 = 38 \text{ MAY MAY S=13.1 I = 48}'$ $R_{p} = (4) \times 7^{3} / 2600 = 38 \text{ MAY MAY S=13.1 I = 48}'$ $R_{p} = (4) \times 7^{3} / 2600 = 38 \text{ MAY MAY $R_{p} = (4) \times 7^{3} / 2600 = 38 \text{ MAY MAY S=13.1 I = 48}'$ $R_{p} = (4) \times 7^{3} / 2600 = 38 \text{ MAY MAY S=13.1 I = 48}'$ $R_{p} = (4) \times 7^{3} / 2600 = 38 \text{ MAY MAY S=13.1 I = 48}'$ $R_{p} = (4) \times 7^{3} / 2600 = 38 \text{ MAY MAY S=13.1 I = 48}'$ $R_{p} = (4) \times 7^{3} / 2600 = 38 \text{ MAY MAY S=13.1 I = 48}'$ $R_{p} = (4) \times 7^{3} / 2600 = 38 \text{ MAY MAY S=13.1 I = 48}'$ $R_{p} = (4) \times 7^{3} / 2600 = 38 \text{ MAY MAY S=13.1 I = 48}'$ $R_{p} = (4) \times 7^{3} / 2600 = 38 \text{ MAY MAY S=13.1 I = 48}'$ $R_{p} = (4) \times 7^{3} / 2600 = 38 \text{ MAY MAY S=13.1 I = 48}'$ $R_{p} = (4) \times 7^{3} / 2600 = 38 \text{ MAY MAY S=13.1 I = 48}'$
BEAM SPAN = $ 2.0"$ W = $50RF$ (60) = $750RF$ AL = $15(250)(6)/95$ = $837W$ $156 + 120F$ 160 $156 + 120F$ 160	Boxm SPAN = 12' w' W = 50 PR (60) will all the must be this set of our all all this set of our all this set of
At = 15 (250) (6) /95 = 83.7 $\%$ St = 15 (1) (12) / (100) = 54.0 $\%$ If = (1) (12) / (260) = 160 = At = 181. Cx12 D.f. 1 LEDGER W= 250 PCF P= 17 (1.38) = 333 + $\sqrt{15} = 15 (333^{4}) / 11 \% = 45.4 PS = 3147$ Let Cx8 Leven W/ 3-50 5 [4x3] 2 Schmis = 1600.	This set of other all things and the property of the set of other and the set of other
$S_{R} = 1.5(1)(12)^{2}/1000 = S_{A},01)$ $S_{R} = 1.5(1)(12)^{2}/1000 = S_{A},01)$ $S_{R} = 1.5(12)^{2}/1000 = S_{A},01)$ $S_{R} = 1.5(12)^{2}/1000 = S_{R},01)$ $S_{R} = 1.$	- The Francist Filt Profest Bit For Bit MC Bit State Table 1 - The Bit
$I_{F} = () () 73/2600 = 166 : - A_{F} = 781. Cx12 P.F.41$ $R = 6 () = 1500 # Use 4x4 Posst on 16" sq. conc. Fig.$ $Ledge R = 78250 P.F P = 17 (1.38) = 333 #$ $Ledge R = 781. Cx12 P.F.41$	The second secon
$ \begin{array}{c ccccccccccccccccccccccccccccccccccc$	
LEDGER W=250 PF P= 1V (138) = 333# Sv=15 (333*) / 11 L. = 45,4 PE 1 JKY SECXBLEWEL W/ 3-505 4x 3/2 SCREWES = 0000.	
Joe CXB LEWEN 14/ 3-505/4×3/2 SCRING 2 600.	and the property of the proper
1 SE CXB LEDEN W/ 3-505 4×3/2 SCRING = 600.	
and the company of th	
	-v=15 (333°) 11 m? = 45,4 ps. 1 JKg

CS Engineering

2420 K Steet, Suite 220; Sacramento, CA. 95816 Phone (916) 658-8600 Fax (916) 658-8601

JOBE5	PLANADE AP	75
SHEET NO.	DI.	of 2
CALCULATED BY	Sodu	_ DATE
CHECKED BY	e l'an	DATE

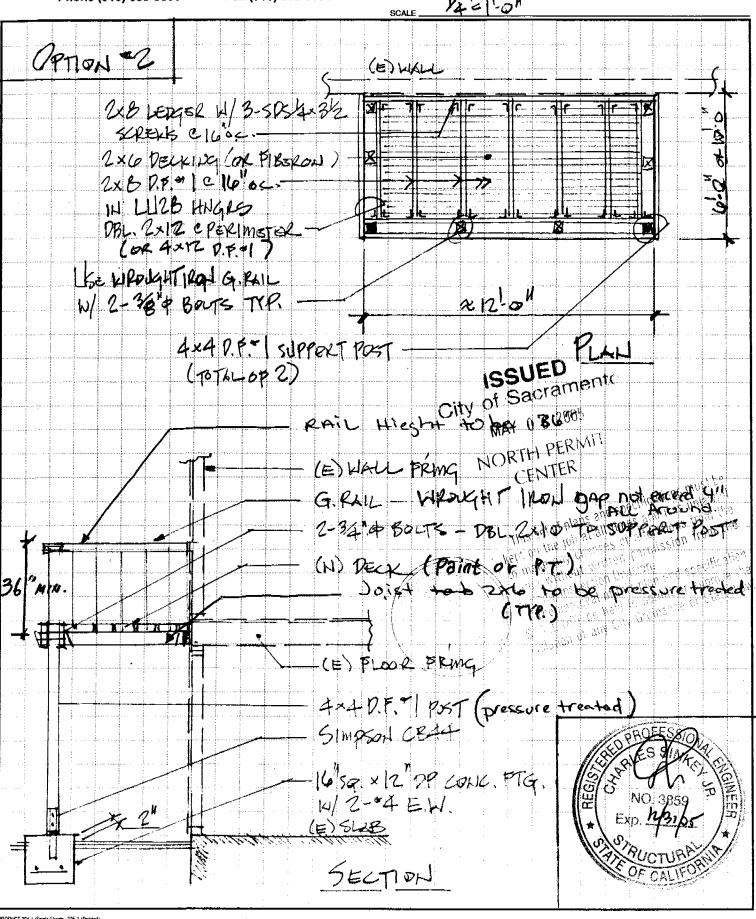



CITY OF SACRAMENTO CALIFORNIA

PLANNING AND BUILDING DEPT.

ZONING DIVISION

Reviewed by: ___

1231 I STREET, ROOM 200 SACRAMENTO, CA 95814-2998

MEMORANDUM OF UNDERSTANDING RELATED TO MITIGATION MEASURES, PLANNING CONDITIONS, ZONING ORDINANCE PROVISIONS, AND/OR SIGN ORDINANCE PROVISIONS

ZONING ORDINANCE PROVISIONS, AND/OR SIGN ORDINANCE PROVISIONS				
In order to proceed with construction/occupancy of the project located at <u>6200 Greenhaven Drive</u>				
I agree that the following Mitigation Measures, Planning Conditions, Zoning Ordinance Provisions, and/or Sign				
Ordinance Provisions associated with project <u>Z04-351</u> will be fully implemented to the (File Number) satisfaction of the City of Sacramento by <u>FINAL INSPECTION</u> . (Date)				
LIST OF MEASURES/CONDITIONS/PROVISIONS:				
 The project shall be constructed in conformance with submitted plans. The applicant shall obtain a building permit prior to commencing construction. This permit allows the removal of the upper balconies on the building located at the northwest corner or Riverside Boulevard and Greenhaven Drive (units 117-124) to be replaced with metal railings that spar the length of the existing slider (see exhibit A). This permit allows the removal of the upper balconies on the remaining buildings to be replaced with wood or wood composite balconies and railings as submitted (see exhibit B). The balconies shall be a minimum width of 4 feet and span the length of the slider. Balconies shall be painted to coordinate with the paint scheme. Any other changes or modifications shall require Planning review and approval. 				
The above language shall not be deemed a waiver by the City of Sacramento of any Mitigation Measure, Plann Condition, Zoning Ordinance Provision, and/or Sign Ordinance Provision applicable to the project whether or the measure, condition, or provision is listed above.				
Signature				
Name & Title:				
Address:				
Phone Number:				

City of Sacramento Planning Division PLANNING REVIEW FOR BUILDING PERMIT SUBMITTAL

ADDRESS: 6200 GREENHAVEN DR	APN: 030-0361-008				
DRPB AREA / PUD / SPD: N/A ZONING: R-3					
EXISTING LAND USE: Apartments.					
PROPOSED USE: Replace existing balcony with new design					
PLANNING STAFF WILL CHECK ONE OR MORE OF THE ITEMS BELOW: Planning review is NOT required.					
Use is NOT allowed; applicant CANNOT submit for plan c	i				
Requires APPLICATION(s): PC ZA IR					
Required Planning application must be submitted before project	et can be submitted for plan check.				
Application(s) IN PROGRESS:					
Applicant may submit for concurrent building permit plan check, at applicant's risk. Building Division must check with Planning staff and/or SITE before issuing building permit.					
XX Application(s) COMPLETED: Z04-351 APPROVED 03-18-2005					
Building permit must conform to approved plans and comply with all conditions of approval. Do NOT issue building permit prior to end of 10 day appeal period.					
XX Plans may be submitted for plan check. Plan checker(s) shall confirm compliance with Zoning Ordinance requirements and all applicable development standards prior to issuance of building permit.					
Meets setback & lot coverage requirements as shown on site plan provided.					
Plans to be submitted have been stamped/signed by Planning counter staff.					
Route to SITE for plan check and inspection.					
Preliminary review ONLY; the information on this form must be reviewed again and confirmed at the time of building permit submittal.					
COMMENTS: Building permit must conform to approved plans and comply with all conditions of approval for Z04-351 .					
DATE: April 5, 2005 BY: Elise Gumm					

CITY OF SACRAMENTO PERMIT ASSISTANCE

0504543

APR 0 5 2005



