

CONSTRUCTION LENDING AGENCY

I hereby affirm under penalty of perjury that there is a construction lending agency for the performance of the work for which this permit is issued (Sec. 3097, Civ.C).

Lenders Name _____

Lenders Address _____

LICENSED CONTRACTORS DECLARATION

I hereby affirm under penalty of perjury that I am licensed under provisions of Chapter 9 (commencing with Section 7000) of Division 3 of the Business and Professions Code and my license is in full force and effect.

License Class _____ Lic. Number _____

Date _____ Contractor _____
(Signature)

OWNER - BUILDER DECLARATION

I hereby affirm under penalty of perjury that I am exempt from the Contractors License Law for the following reason (Sec. 7031.5, Business and Professions Code: Any city or county which requires a permit to construct, alter, improve, demolish, or repair any structure, prior to its issuance, also requires the applicant for such permit to file a signed statement that he or she is licensed pursuant to the provisions of the Contractors License Law (Chapter 9 (commencing with Section 7000) of Division 8 of the Business and Professions Code) or that he or she is exempt therefrom and the basis for the alleged exemption. Any violation of Section 7031.5 by any applicant for a permit subjects the applicant to a civil penalty of not more than five hundred dollars (\$500.00):

I, as owner of the property, or my employees with wages as their sole compensation, will do the work, and the structure is not intended or offered for sale (Sec. 7044, Business and Professions Code: The Contractors License Law does not apply to an owner of property who builds or improves thereon, and who does such work himself or herself or through his or her own employees, provided that such improvements are not intended or offered for sale. If, however, the building or improvement is sold within one year of completion, the owner-builder will have the burden of proving that he or she did not build or improve for the purpose of sale.)

I, as owner of the property, am exclusively contracting with licensed contractors to construct the project (Sec. 7044, Business and Professions Code: The Contractors License Law does not apply to an owner of property who builds or improves thereon, and who contracts for such projects with a contractor(s) licensed pursuant to the Contractors License Law).

I am exempt under Sec. _____ B & P C for this reason _____
Date 7/18/97 Owner Kathleen L. Dallonta
(Signature)

In issuing this building permit, the applicant represents, and the City relies on the representation of the applicant, that the applicant verified all measurements and locations shown on the application or accompanying drawings and that the improvement to be constructed does not violate any law or private agreement relating to permissible or prohibited locations for such improvements. This building permit does not authorize any illegal location of any improvement or the violation of any private agreement relating to location of improvements.

I certify that I have read this application and state that all information is correct. I agree to comply with all city and county ordinances and state laws relating to building construction and hereby authorize representative of this city to enter upon the abovementioned property for inspection purposes.

Date 7/18/97 Signature of Applicant or Agent Kathleen L. Dallonta

BUILDING SITE ADDRESS

1100 41st Street

HV

SUITE

297-H5

INSP. AREA IR

ASSESSOR PARCEL NO. 008-0141-009

COMMUNITY PLAN NO.

PLAN CHECK NO. 2914

NAME OF APPLICANT

ADDRESS

ZIP CODE

PHONE NO.

LICENSED CONTRACTOR

PROPERTY OWNER

James & Kathleen Dallonta

1100 41st St

95819

452-6793

ARCH. ENGR.

LICENSE NO.

NO. OF STORIES

NO. OF ROOMS

ROOF COVERING

AREA 1ST FLOOR

TOTAL AREA

GARAGE AREA

PATIO AREA

USE ZONE

STREET WIDTH

R1

THIS PERMIT IS FOR:

BUILDING MECHANICAL PLUMBING ELECTRICAL SITE FIRE

OCCUP. GROUP

R3

NATURE OF WORK IN DETAIL

Remodel existing Kitchen and add

244 sq. ft.

CONSTR. TYPE

VM

FLOOD STATUS

(Cost &)

SPECIAL CONDITIONS ATTACHMENTS:

CITY OF SACRAMENTO BUILDING INSPECTION DIVISION

PERMIT SERVICES 264-7619

WORKER'S COMPENSATION DECLARATION

I hereby affirm under penalty of perjury one of the following declarations:

I have and will maintain a certificate of consent to self-insure for workers' compensation as provided for by Section 3700 of the Labor Code, for the performance of work for which the permit is issued.

I have and will maintain workers' compensation insurance, as required by Section 3700 of the Labor Code, for the performance of the work for which this permit is issued. My workers' compensation insurance carrier and policy number are:

Carrier _____

Policy Number _____

(This section need not be completed if the permit is for one hundred dollars (\$100) or less) I certify that in the performance of the work for which this permit is issued, I shall not employ any person in any manner so as to become subject to the workers' compensation laws of California and agree that if I should become subject to the workers' compensation provisions of Section 3700 of the Labor Code, I shall forthwith comply with those provisions.

Date 7/18/97 Applicant Kathy Dallonta
(Signature)

WARNING: FAILURE TO SECURE WORKERS' COMPENSATION COVERAGE IS UNLAWFUL AND SHALL SUBJECT AN EMPLOYER TO CRIMINAL PENALTIES AND CIVIL FINES UP TO ONE HUNDRED THOUSAND DOLLARS (\$100,000) IN ADDITION TO THE COST OF COMPENSATION. DAMAGES AS PROVIDED FOR IN SECTION 3706 OF THE LABOR CODE, INTEREST AND ATTORNEY'S FEES.

VALUATION \$ 25999

ISSUED BY: Nakashima

DATE ISSUED 7/31/97

BUILDING PERMIT FEE \$ 465

~~10,000~~ PROC. FEE \$ 156

S.M.I. FEE \$ 200

CONST. EXCISE TAX \$ 102.34

CITY BUS LICENSE \$ 1

TECH. FEE \$ 2485

WATER DEV. FEE \$ 1

CITY SEWER DEV. FEE \$ 1

REG. SEWER FEE \$ 0

RESIDENTIAL CONST. TAX \$ 6


7

7

R


TOTAL FEES \$ 594.29

THIS PERMIT SHALL EXPIRE BY LIMITATION IF WORK AUTHORIZED IS NOT COMMENCED WITHIN 180 DAYS.

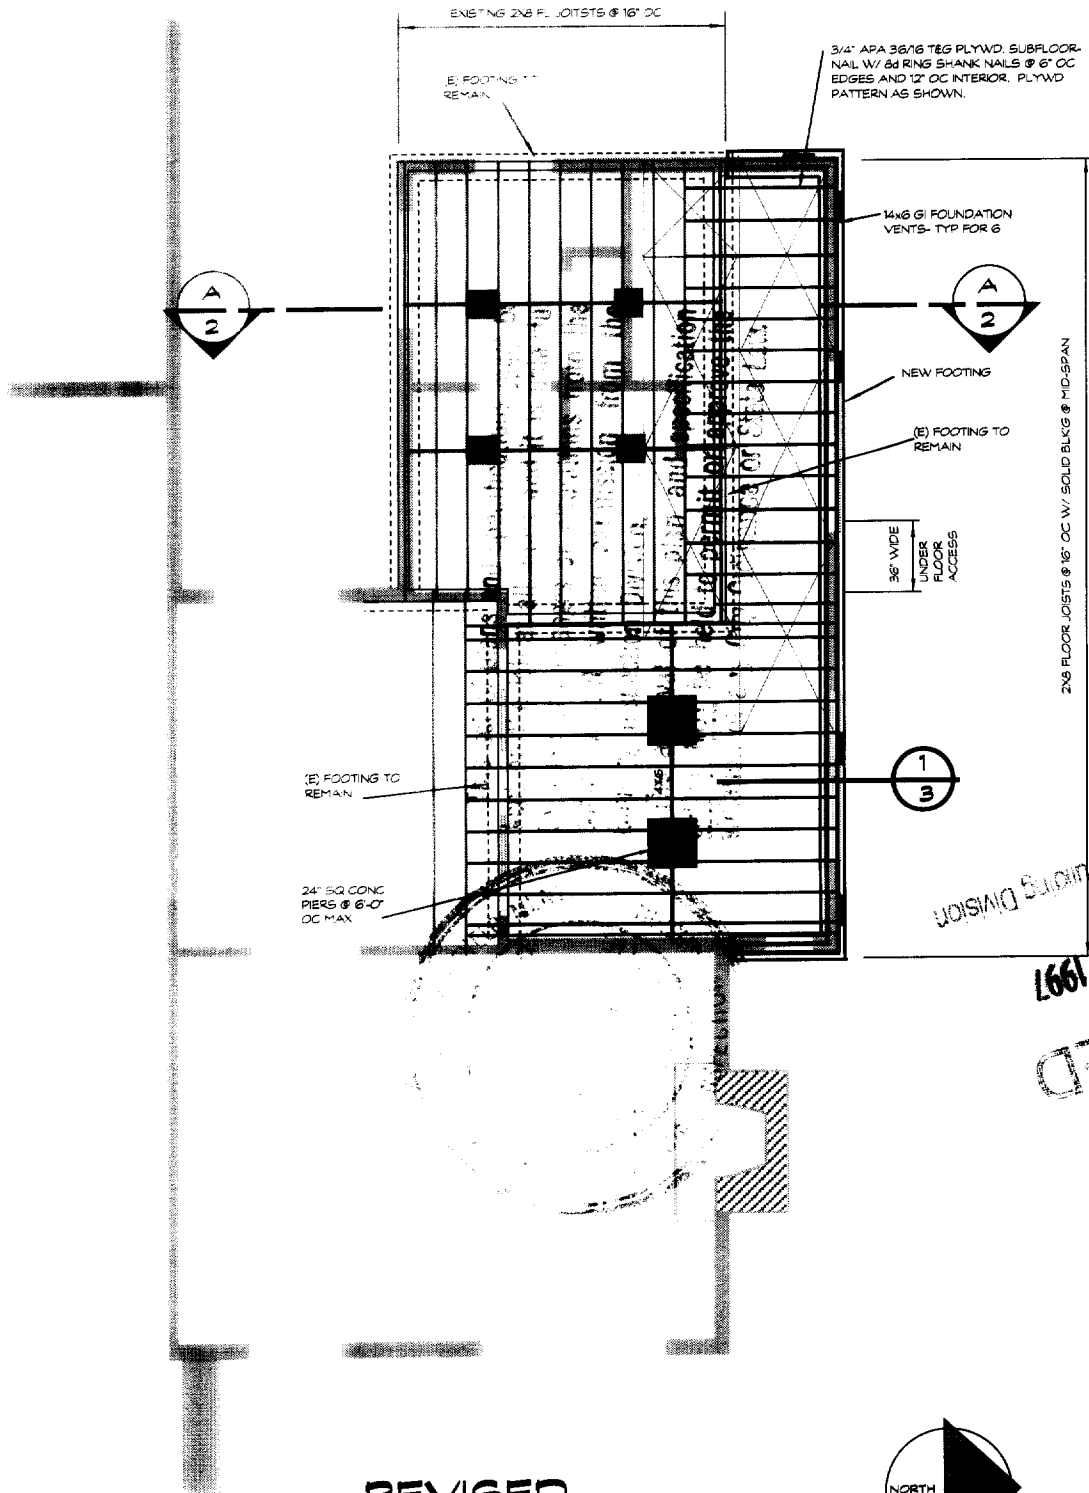

SACRAMENTO BUILDING DIVISION
 AUG 06 1997
 ISSUED

REVISED FOUNDATION PLAN

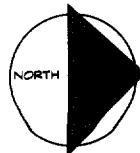

SCALE 1/8" = 1'-0"

RESIDENCE REMODEL		CO 1
MR. & MRS. JAMES DALLOSTA 1100 41st STREET SACRAMENTO, CA 95819		
		8/5/97